

***Regular Meeting of the
Abatement Appeals Board
July 16, 2025***

***Appellant Statement
Exhibit E***



Welcome to our Permit / Complaint Tracking System!

COMPLAINT DATA SHEET

Complaint Number: 202179766

Owner/Agent: OWNER DATA SUPPRESSED

Owner's Phone: --

Contact Name: --

Contact Phone: --

Complainant: COMPLAINANT DATA SUPPRESSED

Date Filed: --

Location: 338 TEDDY AV

Block: 6210

Lot: 012

Site: --

Rating: --

Occupancy Code: --

Received By: WSTROM

Division: BID

Complainant's Phone: --

Complaint Source: WEB FORM

Assigned to Division: CES

Description: date last observed: 31-MAY-21; identity of person performing the work: I wish to remain anonymous; exact location: In-Law Unit; building type: Residence/Dwelling ILLEGAL UNIT; WORK W/O PERMIT; ILLEGAL CHANGE OF USE; OTHER PLUMBING; ; additional information: Illega kithchen in downstairs unit w/o permit;

Instructions:

INSPECTOR CURRENTLY ASSIGNED

DIVISION	INSPECTOR	ID	DISTRICT	PRIORITY
CES	MCCONN	6960		

REFERRAL INFORMATION

DATE	REFERRED BY	TO	COMMENT
12/9/2022	Suzanna Wong	CES	Per Jimmy Gualumi

COMPLAINT STATUS AND COMMENTS

DATE	TYPE	INSPECTOR	STATUS	COMMENT	UPDATED BY	DIV
07/07/21	CASE OPENED	Walsh	CASE RECEIVED		William Strom 07-JUL-21	IPR
07/07/21	OTHER BLDG/ HOUSING VIOLATION	Gualumi	CASE UPDATE	Case reviewed and assigned to complaint investigation team per MH; WS	William Strom 07-JUL-21	IPR
07/09/21	OTHER BLDG/ HOUSING VIOLATION	Gualumi	CASE UPDATE	Met with electrical contractor. Site inspection revealed a bathroom, wet bar and 3 Storage rooms at ground Floor. Permit research Required. Jg		BID
07/12/21	OTHER BLDG/ HOUSING VIOLATION	Gualumi	CASE UPDATE	Posted nov. Jg		BID
07/12/21	OTHER BLDG/ HOUSING VIOLATION	Gualumi	FIRST NOV SENT	1st NOV issued per JG; ag	Audrey Gee 13-JUL-21	INS
07/13/21	OTHER BLDG/ HOUSING VIOLATION	Gualumi	CASE UPDATE	1st NOV mailed; ag	Audrey Gee 13-JUL-21	INS
08/12/21	OTHER BLDG/ HOUSING VIOLATION	Gualumi	CASE UPDATE	PA 202108116263 filed to comply with NOV. JG		BID

RESIDENTIAL ADDITION

338 TEDDY AVENUE
SAN FRANCISCO, CA 94134

DESIGNER:
LCF SOLUTIONS INC.
FELIX LIU 415.517.4448



RESIDENTIAL ADDITION

338 TEDDY AVENUE
SAN FRANCISCO, CA 94134

SYMBOLS & ABBREVIATIONS

ø	DIAMETER	ID	INSIDE DIAMETER
&	AND	INT	INTERIOR
ADD'L	ADDITIONAL	JT	JOINT
ADJ	ADJACENT		
A.F.F.	ABOVE FINISHED FLOOR	LOC	LOCATION
ALT	ALTERNATIVE		
BLDG.	BUILDING	MAX	MAXIMUM
BLK	BLOCK	MB	MACHINE BOLT
BLKG	BLOCKING	MECH	MECHANICAL
BM	BEAM	MFR.	MANUFACTURE
BOT	BOTTOM	MIN	MINIMUM
BTB	BACK TO BACK	MISC.	MISCELLANEOUS
BTWN	BETWEEN		
		(N)	NEW
CANT.	CANTILEVER	NO.	NUMBER
CBC	CALIFORNIA BUILDING CODE	NTS	NOT TO SCALE
C.H.	CEILING HEIGHT	N.S.	NEAR SIDE
CC	CENTER TO CENTER		
CJ	CONSTRUCTION JOINT	OC	ON CENTER
CLR	CLEAR	OD	OUTSIDE DIAMETER
COL.	COLUMN	OH	OPPOSITE HAND
CONN.	CONNECTION	OPNG	OPENING
CONT.	CONTINUED	OPP	OPPOSITE
CTR	CENTER	PERP	PERPENDICULAR
D.	DRYER	REF	REFERENCE
DBL	DOUBLE	REINF	REINFORCEMENT
DIA.	DIAMETER	REQD	REQUIRED
DIAG.	DIAGONAL	REV	REVISION
DN	DOWN		
DO	DITTO	SCHED	SCHEDULE
DEMO.	DEMOLISH	SHT	SHEET
DET	DETAIL	SIM	SIMILAR
DWG	DRAWING	SOG	SLAB ON GRADE
		SPEC(S)	SPECIFICATION(S)
(E)	EXISTING	STD	STANDARD
EA.	EACH	STL	STEEL
E.E.	EACH END	STOR.	STORAGE
E.F.	EACH FACE	STRUC	STRUCTURAL
EL	ELEVATION	SYM.	SYMMETRICAL
EQ	EQUAL		
E.S.	EACH SIDE	T.O.	TOP OF
E.W.	EACH WAY	T.O.C.	TOP OF CONCRETE
EXT	EXTERIOR	T.O.S.	TOP OF STEEL OR SLAB
E.O.D.	EDGE OF DECK	T.O.W.	TOP OF WALL
E.O.S.	EDGE OF SLAB	TYP.	TYPICAL
FIN	FINISH(ED)	U.N.O.	UNLESS NOTED OTHERWISE
FDN	FOUNDATION		
FF	FINISH FLOOR	VERT	VERTICAL
FLR.	FLOOR	V.I.F.	VERIFY IN FIELD
FOC	FACE OF CONCRETE		
FOS	FACE OF STUD	W/	WITH
F.S.	FAR SIDE	W/O	WITHOUT
FTG	FOOTING	W.	WASHER
GA	GAGE		
GALV	GALVANIZED		
GB	GRADE BEAM		
HDR	HEADER		

GENERAL NOTES


- CONTRACTOR SHALL COMPLY WITH CODES, LAWS, ORDINANCES, RULES AND REGULATIONS OF PUBLIC AUTHORITIES GOVERNING THE WORK.
- CONTRACTOR IS RESPONSIBLE FOR VERIFICATION OF EXISTING CONDITIONS AND DIMENSIONS. THE CONTRACTOR SHALL NOTIFY THE ENGINEER AND THE OWNER OF THE DISCREPANCIES BETWEEN THE CONSTRUCTION DOCUMENTS AND FIELD CONDITIONS PRIOR TO CONSTRUCTION.
- ALL WORK PERFORMED SHALL COMPLY WITH THE CONTRACT DOCUMENTS, DRAWINGS AND SPECIFICATIONS INCLUDING THESE GENERAL NOTES. THE CONTRACTOR SHALL COORDINATE THE INTENT OF THE GENERAL NOTES WITH ALL TRADES.
- CONTRACTOR TO REVIEW DOCUMENTS, VERIFY DIMENSIONS AND FIELD CONDITIONS AND CONFIRM THAT WORK IS BUILDABLE AS SHOWN. REPORT ANY CONFLICTS OF OMISSIONS TO THE ENGINEER FOR CLARIFICATION PRIOR TO PERFORMING ANY WORK IN QUESTION.
- ALL MATERIALS AND WORKMANSHIP SHALL CONFORM TO THE DRAWINGS AND SPECIFICATIONS.
- NO DEVIATION FROM THE CONTRACT DRAWINGS AND SPECIFICATIONS SHALL BE MADE WITHOUT WRITTEN APPROVAL OF THE ENGINEER OR DESIGNER.
- DO NOT SCALE DRAWINGS. DIMENSIONS SHALL TAKE PRECEDENCE OVER SCALES SHOWN ON DRAWINGS. CONTRACTOR SHALL VERIFY ALL DIMENSIONS AND CONDITIONS TO COMMENCING WORK AND REPORT ANY DISCREPANCIES.
- ALL DIMENSIONS ARE FROM FINISH FACE TO FINISH FACE, UNLESS OTHERWISE NOTED. ALLOW FOR THICKNESS OF FINISH.

ALL WORK SHALL CONFORM TO THE MINIMUM STANDARDS OF THE:


- 2019 CALIFORNIA BUILDING CODE
- 2019 CALIFORNIA PLUMBING CODE
- 2019 CALIFORNIA MECHANICAL CODE
- 2019 CALIFORNIA ELECTRICAL CODE
- 2019 CALIFORNIA FIRE CODE
- 2019 CALIFORNIA EXISTING BUILDING CODE
- 2019 CALIFORNIA ENERGY CODE
- 2019 CALIFORNIA GREEN BUILDING STANDARDS CODE
- LOCAL AND STATE AMENDMENTS, ORDINANCES AND LAW

ALL WORK SHALL MEET TITLE 24, CALIFORNIA ADMINISTRATIVE CODE STANDARDS FOR CONSTRUCTION IN A SEISMIC ZONE. ANY PORTION OF THE WORK SHALL ALSO CONFORM TO THE STATE OF CALIFORNIA DIVISION OF INDUSTRIAL SAFETY AND THOSE CODES AND STANDARDS LISTED IN THESE NOTES. ALL CODES HAVING JURISDICTION SHALL BE OBSERVED STRICTLY IN THE CONSTRUCTION OF THE PROJECT INCLUDING ALL APPLICABLE STATE, CITY AND COUNTY BUILDING, ZONING, ELECTRICAL, MECHANICAL, PLUMBING AND FIRE CODES. CONTRACTOR SHALL VERIFY ALL CODE REQUIREMENTS BEFORE COMMENCEMENT OF CONSTRUCTION, CONSTRUCTION AND BRING ANY DISCREPANCIES BETWEEN CODE REQUIREMENTS AND DOCUMENTS TO THE ATTENTION OF THE DESIGNER/DRAFTER IN WRITING. WHERE REFERENCE IS MADE TO VARIOUS TEST STANDARDS FOR MATERIALS. SUCH STANDARDS SHALL BE THE LATEST EDITION AND / OR ADDENDUM.

SITE PLAN

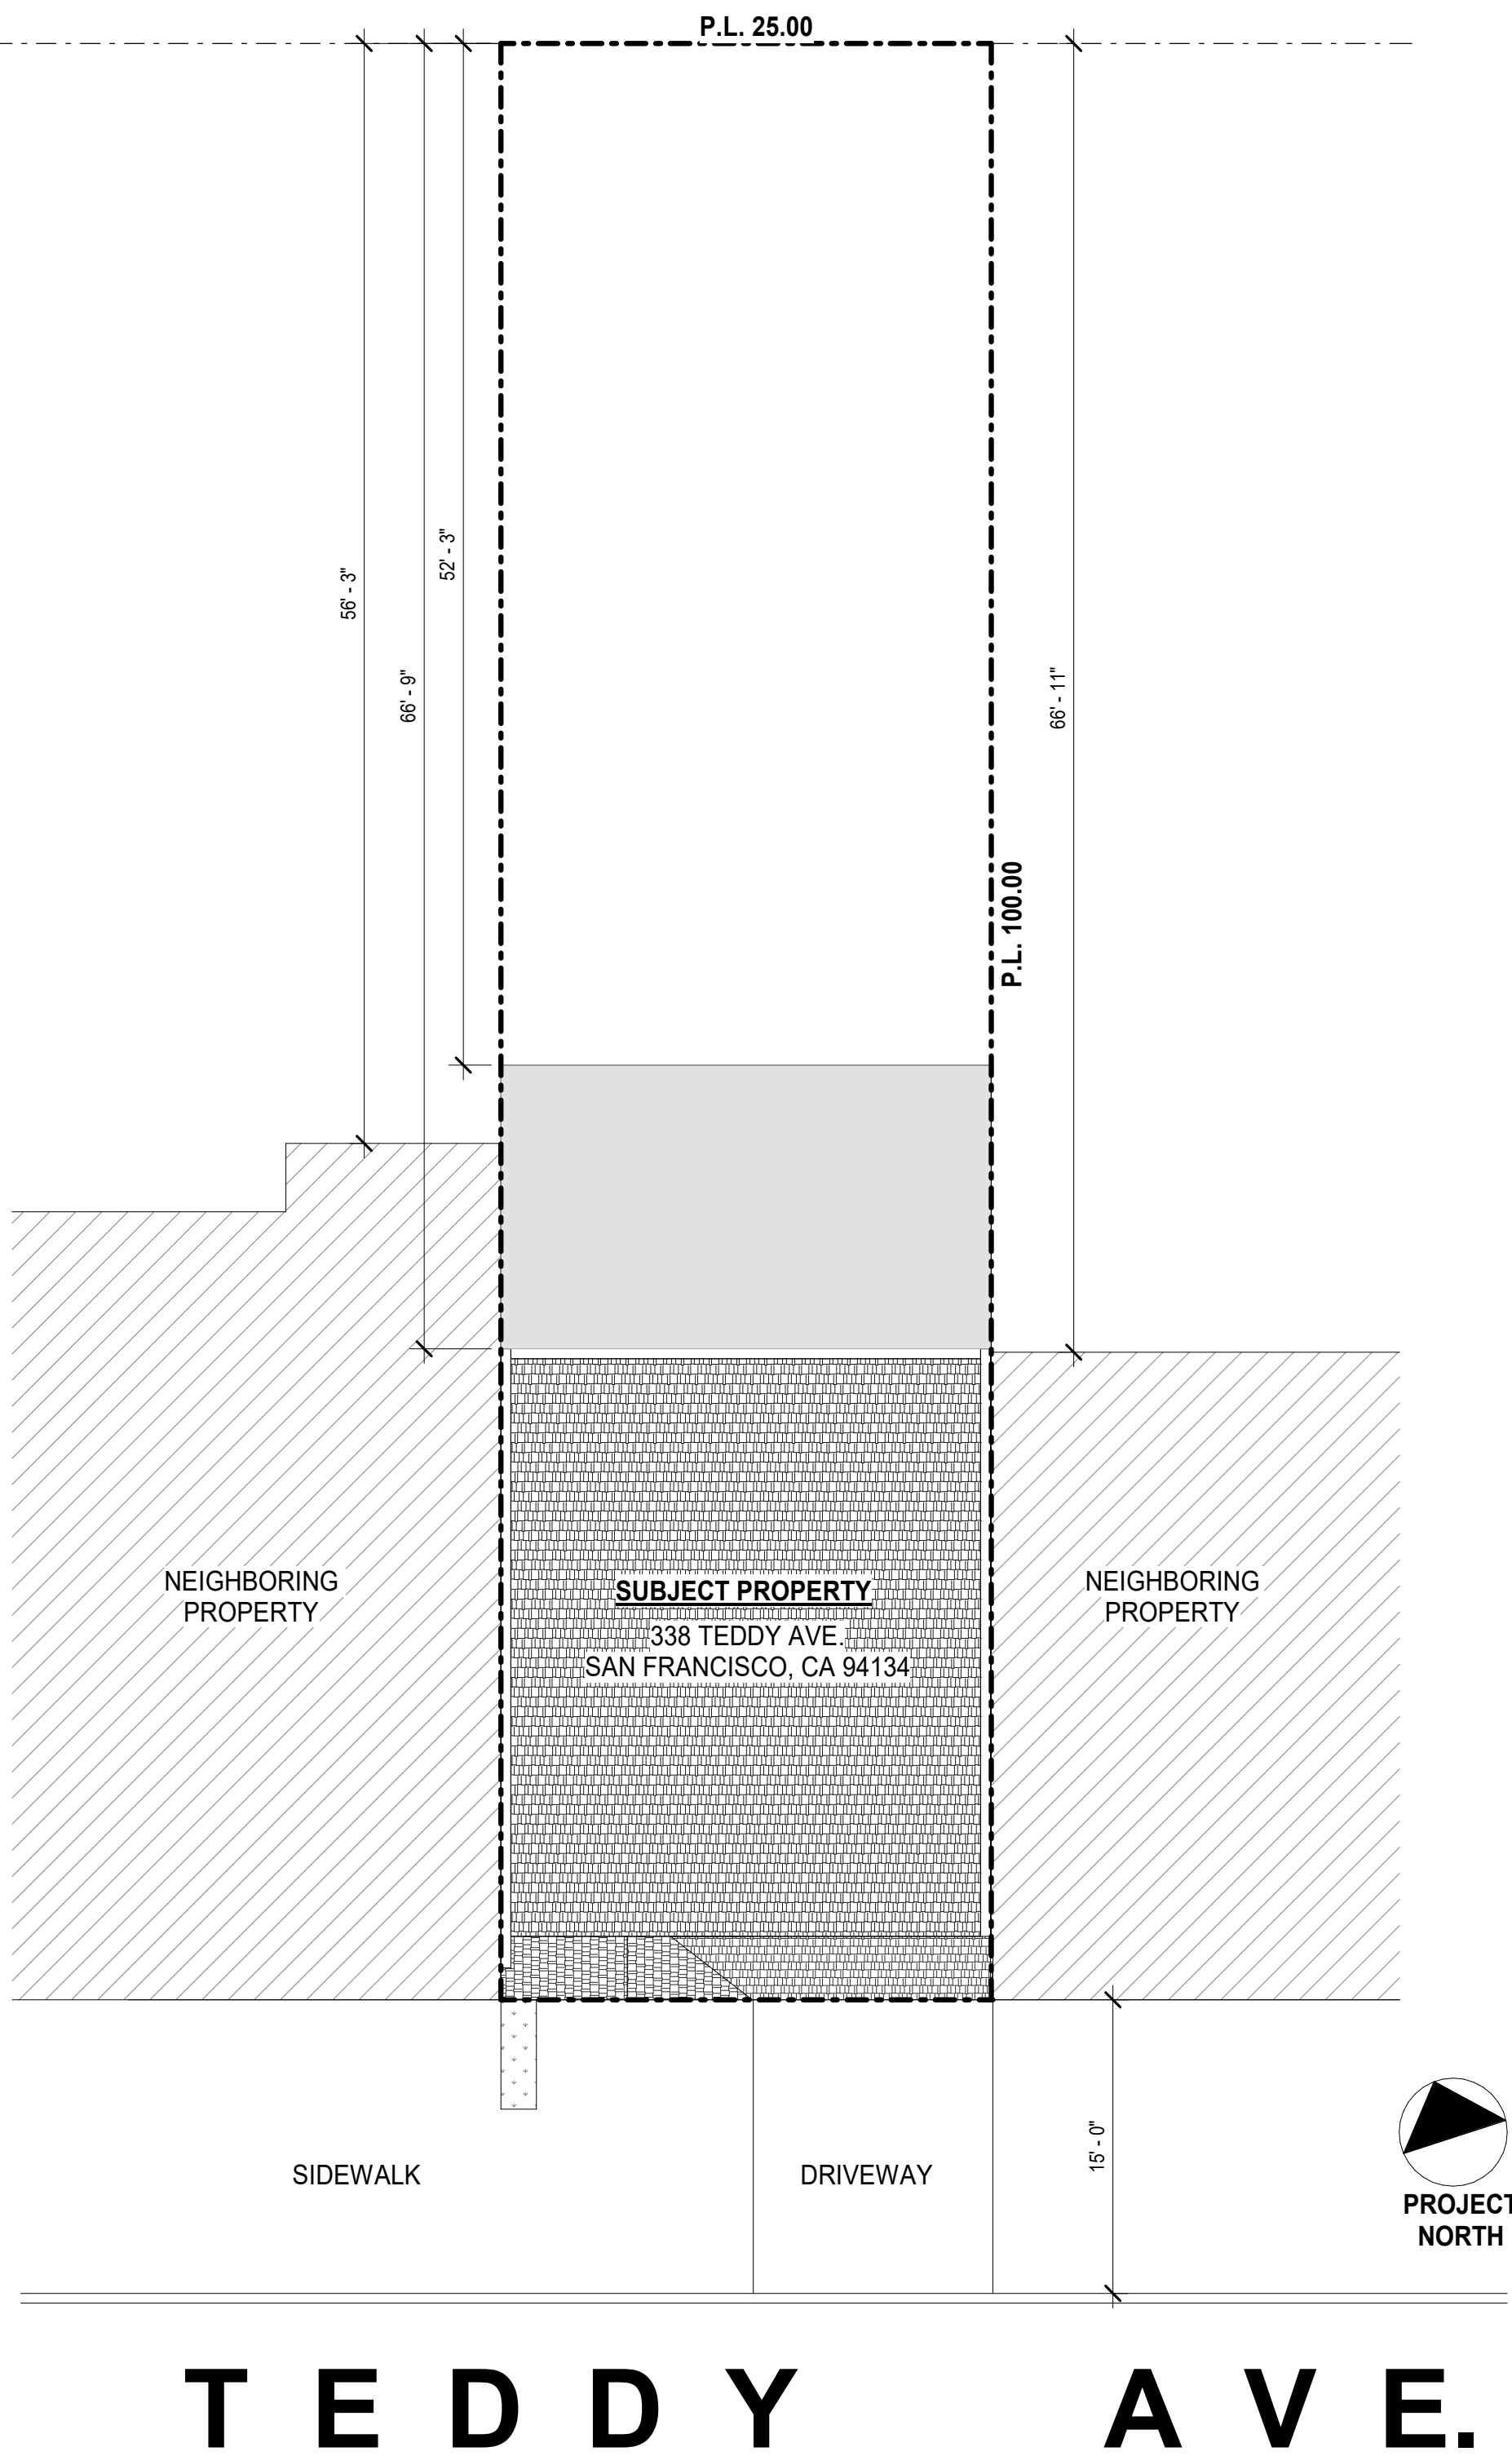

REFERENCE SYMBOLS

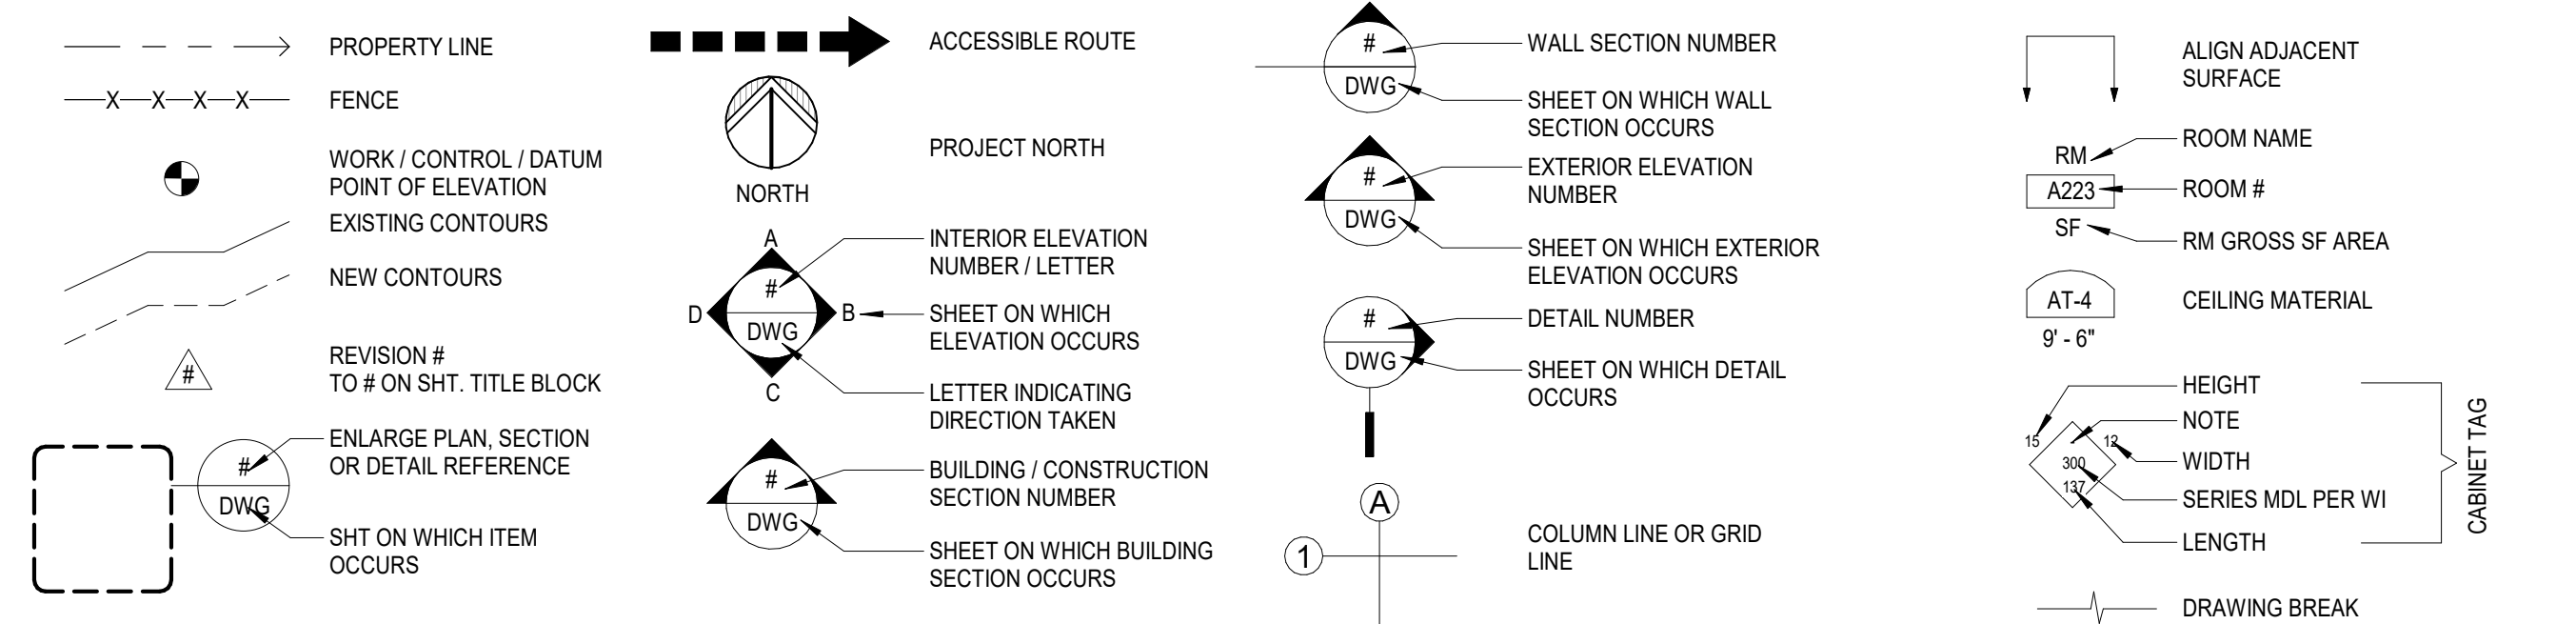

PROJECT DATA

BLOCK/LOT NO.	6210 / 012
BUILDING ADDRESS	338 TEDDY AVENUE SAN FRANCISCO, CA 94134
NUMBER OF STORIES	2 STORIES
HEIGHT	30' - 3" FT (40x MAX)
NUMBER OF STORIES	3 STORIES
HEIGHT	30' - X" FRONT (40'-0 LIMIT)
CONSTRUCTION	TYPE VB CONSTRUCTION
ZONING	RH-1 *SINGLE FAMILY
FIRE SPRINKLERS	NONE

VICINITY MAP



PROJECT DESCRIPTION

SCOPE OF WORK:

PERMIT TO BE IN COMPLIANCE WITH NOV/COMPLAINT# 202179766

- LEGALIZE GROUND FLOOR ADDITION** (APPROX. 792 SF):
 - NEW BEDROOM
 - NEW RECREATION ROOM
 - NEW CLOSET
 - NEW BAR/LOUNGE
 - NEW BATHROOM
 - NEW LAUNDRY

SHEET INDEX

A0.0	PROJECT INFO
A0.1	GREEN BUILDING REQS.
A1.0	EXISTING & PROPOSED FLOOR PLANS
A3.0	TYPICAL DETAILS & SCHEDULES
E1.0	EXISTING & PROPOSED POWER LAYOUT
E1.1	EXISTING & PROPOSED LIGHTING LAYOUT
S1.0	STRUCTURAL SHEET INDEX AND STRUC. GEN. NOTES
S1.1	SLOPE & SEISMIC PROTEC. CHKLIST
S1.2	TYPICAL STRUCTURAL DETAILS
S1.3	TYPICAL STRUCTURAL DETAILS
S1.4	TYPICAL STRUCTURAL DETAILS
S1.5	TYPICAL STRUCTURAL DETAILS
S1.6	TYPICAL STRUCTURAL DETAILS
S2.0	PROPOSED STRUCTURAL FLOOR PLAN
S3.0	STRUCTURAL DETAILS

PROJECT TITLE

RESIDENTIAL ADDITION

338 TEDDY AVENUE
SAN FRANCISCO, CA 94134

FILE NO.

DRWN BY: SHERYLL

DATE : 07/25/2021

CHK'D BY F.LIU

PROJ. NO. 2111

SCALE As indicated

SHEET DESCRIPTION

PROJECT INFO

SHEET NO.

A0.0

GS5: San Francisco Green Building Submittal Form for Residential Alteration + Addition Projects

Form version: March 11, 2020 (For permit applications January 2020 - December 2022)

INSTRUCTIONS:

1. Fill out the project information in the Verification box at the right.

2. Submittal must be a minimum of 11" x 17".

3. This form is for permit applications submitted January 2020 through December 2022.

TITLE

SOURCE OF REQUIREMENT

DESCRIPTION OF REQUIREMENT

RESIDENTIAL

GRADING & PAVING

CALGreen 4.106.3

Show how surface drainage (grading, swales, drains, retention areas) will keep surface water from entering the building.

RODENT PROOFING

CALGreen 4.406.1

Seal around pipe, cable, conduit, and other openings in exterior walls with cement mortar or DBI-approved similar method.

FIREPLACES & WOODSTOVES

CALGreen 4.503.1

Install only direct-vent or sealed-combustion, EPA Phase II-compliant appliances.

CAPILLARY BREAK, SLAB ON GRADE

CALGreen 4.505.2

Slab on grade foundation requiring vapor retarder also requires a capillary break such as: 4 inches of base 1/2-inch aggregate under retarder; slab design specified by licensed professional.

MOISTURE CONTENT

CALGreen 4.505.3

Wall + floor <19% moisture content before enclosure.

BATHROOM EXHAUST

CALGreen 4.506.1

Must be ENERGY STAR compliant, ducted to building exterior, and its humidistat shall be capable of adjusting between <50% to >80% (humidistat may be separate component).

MATERIAL EMISSIONS

LOW-EMITTING MATERIALS

CALGreen 4.504.2.1-5, SFGBC 4.103.3.2

Use products that comply with the emission limit requirements of 4.504.2.1-5, 5.504.4.1-6 for adhesives, sealants, paints, coatings, carpet systems including cushions and adhesives, resilient flooring (80% of area), and composite wood products.

WATER

INDOOR WATER USE REDUCTION

CALGreen 4.303.1, SF Housing Code sec.12A10

Meet flush/flow requirements for: toilets (1.28 gpf); urinals (0.125 gpf wall, 0.5 gpf floor); showerheads (1.8 gpm); lavatories (1.2 gpm private, 0.5 gpm public/common); kitchen faucets (1.8 gpm); wash fountains (1.8 gpm); metering faucets (0.2 gpc); food waste disposers (1 gpm/8 gpm). Residential major improvement projects must upgrade all non-compliant fixtures per SF Housing Code sec.12A10.

WATER-EFFICIENT IRRIGATION

Administrative Code ch.63

If modified landscape area is ≥1,000 sq.ft., use low water use plants or climate appropriate plants, restrict turf areas and comply with Model Water Efficient Landscape Ordinance restrictions by calculated ETAF of ≤.55 or by prescriptive compliance for projects with ≤2,500 sq.ft. of landscape area.

ENERGY

ENERGY EFFICIENCY

CA Energy Code

Comply with all provisions of the CA Energy Code.

PARKING

BICYCLE PARKING

Planning Code sec.155.1-2

Provide short- and long-term bike parking to meet requirements of SF Planning Code sec.155.1-2.

RESOURCE RECOVERY

RECYCLING BY OCCUPANTS

SF Building Code 106A.3.3, CalGreen 5.410.1, AB-088

Provide adequate space and equal access for storage, collection, and loading of compostable, recyclable and landfill materials.

CONSTRUCTION & DEMOLITION (C&D) DISCARDS MANAGEMENT

Environment Code ch. 14 SFGBC 4.103.2.3 CalGreen 4.408.2, 4.408.5

Construction Discards Management - 100% of mixed debris must be taken by a Registered Transporter to a Registered facility and processed for recycling. Demonstrate ≥65% recovery. See www.dbi.org for details.

HVAC

HVAC INSTALLER QUALS

CALGreen 4.702.1

Installers must be trained in best practices.

HVAC DESIGN

CALGreen 4.507.2

HVAC shall be designed to ACCA Manual J, D, and S.

GOOD NEIGHBOR

BIRD-SAFE BUILDINGS

Planning Code sec.139

Glass facades and bird hazards facing and/or near Urban Bird Refuges may need to treat their glass for opacity.

TOBACCO SMOKE CONTROL

Health Code art.19F

Prohibit smoking within 10 feet of building entries, air intakes, and operable windows and enclosed common areas.

POLLUTION PREVENTION

STORMWATER CONTROL PLAN

Public Works Code art.4.2 sec.147

Projects disturbing ≥5,000 sq.ft. in combined or separate sewer areas, or replacing ≥2,500 impervious sq.ft. in separate sewer area, must implement a Stormwater Control Plan meeting SFPUC Stormwater Management Requirements.

CONSTRUCTION SITE RUNOFF

Public Works Code art.4.2 sec.146

Provide a construction site Stormwater Pollution Prevention Plan and implement SFPUC Best Management Practices.

INDOOR AIR QUALITY

AIR FILTRATION (CONSTRUCTION)

CALGreen 4.504.1

Seal permanent HVAC ducts/equipment stored onsite before installation.

FOR YOUR INFORMATION: INDOOR WATER EFFICIENCY

Indoor Water Efficiency

Each fixture must not exceed CALGreen 4.303 maximum flow rates:

FIXTURE TYPE	MAXIMUM FIXTURE FLOW RATE
Showerheads²	1.8 gpm @ 80 psi
Lavatory Faucets: residential	1.2 gpm @ 60 psi
Kitchen Faucets	1.8 gpm @ 60 psi default
Wash Fountains	1.8 gpm / 20 [rim space (inches) @ 60 psi]
Metering Faucets	.20 gallons per cycle
Tank-type water closets	1.28 gallons / flush¹ and EPA WaterSense Certified
Flushometer valve water closets	1.28 gallons / flush¹
Urinals	Wall mount: 0.125 gallons / flush Floor mount: 0.5 gallons / flush

NOTES:

1. For dual flush toilets, effective flush volume is defined as the composite, average flush volume of two reduced flushes and one full flush. The referenced standard is ASME A112.19.14 and USEPA WaterSense Tank-Type High Efficiency Toilet Specification – 1.28 gal (4.8L)

2. The combined flow rate of all showerheads in one shower stall shall not exceed the maximum flow rate for one showerhead, or the shower shall be designed to allow only one showerhead to be in operation at a time (CALGreen 5.303.2.1)

Water Efficiency of Existing Non-Compliant Fixtures

All fixtures that are not compliant with the San Francisco Commercial Water Conservation Ordinance that serve or are located within the project area must be replaced with fixtures or fittings meeting the maximum flow rates and standards referenced above. For more information, see the Commercial Water Conservation Program Brochure, available at SFDBI.org.

NON-COMPLIANT PLUMBING FIXTURES INCLUDE:

1. Any toilet manufactured to use more than 1.6 gallons/flush

2. Any urinal manufactured to use more than 1 gallon/flush

3. Any showerhead manufactured to have a flow capacity of more than 2.5 gpm

4. Any interior faucet that emits more than 2.2 gpm

Exceptions to this requirement are limited to situations where replacement of fixture(s) would detract from the historic integrity of the building, as determined by the Department of Building Inspection pursuant to San Francisco Building Code Chapter 13A.

OTHER RESIDENTIAL ALTERATIONS + ADDITIONS

adds any amount of conditioned area, volume, or size

if applicable

VERIFICATION

Indicate below who is responsible for ensuring green building requirements are met. Projects that increase total conditioned floor area by ≥1,000 sq. ft. are required to have a Green Building Compliance Professional of Record as described in Administrative Bulletin 93. For projects that increase total conditioned floor area by <1,000 sq. ft., the applicant or design professional may sign below, and no license or special qualifications are required. FINAL COMPLIANCE VERIFICATION form will be required prior to Certificate of Completion

LEGALIZE GROUND FLOOR ADDITION

PROJECT NAME

6210 / 012

BLOCK/LOT

338 TEDDY AVENUE, SAN FRANCISCO, CA 94134

ADDRESS

PRIMARY OCCUPANCY

GROSS BUILDING AREA

INCREASE IN CONDITIONED FLOOR AREA

I have been retained by the project sponsor to verify that approved construction documents and construction fulfill the requirements of San Francisco Green Building Code. It is my professional opinion that the requirements of the San Francisco Green Building Code will be met. I will notify the Department of Building Inspection if the project will, for any reason, not substantially comply with these requirements, if I am no longer the Green Building Compliance Professional of Record for the project, or if I am otherwise no longer responsible for assuring the compliance of the project with the San Francisco Green Building Code.

LICENSED PROFESSIONAL (sign & date)

May be signed by applicant when <1,000 sq. ft. is added.

AFFIX STAMP BELOW:

Projects that increase total conditioned floor area by ≥1,000 sq.ft.: Green Building Compliance Professional of Record will verify compliance.

GREEN BUILDING COMPLIANCE PROFESSIONAL (name & contact phone #)

FIRM

I am a LEED Accredited Professional

I am a GreenPoint Rater

I am an ICC Certified CALGreen Inspector

GREEN BUILDING COMPLIANCE PROFESSIONAL (sign & date)

Signature by a professional holding at least one of the above certifications is required. If the Licensed Professional does not hold a certification for green design and/or inspection, this section may be completed by another party who will verify applicable green building requirements are met.

DESIGNER:

LCF SOLUTIONS INC.

FELIX LIU 415.517.4448

LCF solutions

REGISTERED PROFESSIONAL ENGINEER

NO. C 83626

CIVIL

STATE OF CALIFORNIA

RESIDENTIAL ADDITION

338 TEDDY AVENUE

SAN FRANCISCO, CA 94134

PROJECT TITLE

RESIDENTIAL ADDITION

338 TEDDY AVENUE

SAN FRANCISCO, CA 94134

FILE NO.

DRWN BY: SHERYLL

DATE : 12/30/2020

CHK'D BY F. LIU

PROJ. NO. 2111

SCALE

SHEET DESCRIPTION

GREEN BUILDING REQS.

SHEET NO.

A0.1

GENERAL NOTES

1.

ALL WORK AND MATERIAL TO BE IN ACCORDANCE WITH REGULATIONS AND BUILDING CODES OF SAN FRANCISCO.
2.

ALL DIMENSIONS AND EXISTING CONDITIONS TO BE VERIFIED IN THE FIELD PRIOR TO COMMENCING WORK AND SHALL BE THE RESPONSIBILITY OF THE CONTRACTOR.
3.

BUILDING - FIRE PROTECTION

(A) EXISTING BEDROOMS; PROVIDE SMOKE DETECTORS, BATTERY OPERATED, IN ALL (E) BEDROOMS AND OR ADJACENT HALLWAY OR SPACES. SMOKE DETECTORS SHALL RECEIVE PRIMARY POWER BUILDING WIRING AND SHALL BE EQUIPPED WITH BATTERY BACKUP IN ALL NEW CONSTRUCTION. (CBC 310.9)

(B) CARBON MONOXIDE ALARMS ARE TO BE LOCATED AS FOLLOWS: (CBC 420.4)

(1) OUTSIDE THE SLEEPING AREAS IN THE IMMEDIATE VICINITY OF THE BEDROOM.

(2) ON EVERY LEVEL OF THE BUILDING INCLUDING BASEMENTS.

(C) PROVIDE 5/8" TYPE X GYP. BD. ON GARAGE WALLS, POST, BEAMS AND CEILING. ANY DOOR BETWEEN THE HOUSE AND GARAGE MUST BE SELF-CLOSING AND BE A 20-MINUTE RATED AND LABELED DOOR OR A MINIMUM 1 3/8" THICK, SOLID WOOD DOOR. WHERE A MIN. OF TWO SELF CLOSING HINGES ARE USED.(CBC 302,312.4)
4.

BUILDING - EGRESS

EMERGENCY ESCAPE WINDOWS SHALL HAVE MIN. NET CLEAR OPENABLE AREA OF 5.7 SQ. FT. MINIMUM NET CLEAR OPENABLE HEIGHT DIM. SHALL BE 24 INCHES. FINISHED SILL HEIGHT NOT TO EXCEED 44 INCHES ABOVE FINISHED FLOOR. BARS, GRILLES, GRATES, OR SIMILAR DEVICES MAY BE INSTALLED PROVIDED THAT SUCH DEVICES ARE EQUIPPED WITH APPROVED RELEASE MECHANISMS WHICH ARE OPENABLE FROM THE INSIDE. (CBC 310.4)
5.

ELECTRICAL - GENERAL

(A) PROVIDE TAMPER-RESISTANT WALL RECEPTACLES IN HABITABLE ROOMS MAX. 12" O.C., AND MAX. 6' FROM ANY OPENING & AT WALLS LONGER THAN 2'. (CEC 210.5)

(B) PROVIDE A 20AMP DEDICATED CIRCUIT FOR NEW BATHROOM. PROVIDE GFCI PROTECTED, TAMPER RESISTANT RECEPTACLE WITHIN 3' OF THE BATHROOM LAVATORY, OR ON THE SIDE OF THE VANITY CABINET WITHIN 12" OF THE TOP. ALL LIGHTING INSTALLED OVER SHOWER OR TUB SHALL BE MARKED SUITABLE FOR WET LOCATIONS. NO RECEPTACLES ARE PERMITTED IN A TUB OR SHOWER SPACE.

(D) ALL 15 AND 20 AMPERE RECEPTACLS SHALL BE TAMPER RESISTANT.

(E) PROVIDE A DEDICATED CIRCUIT FOR A DISHWASHER.

(F) PROVIDE A DEDICATED CIRCUIT FOR A DISPOSAL.
5.

ELECTRICAL - GENERAL

(G) PROVIDE A DEDICATED CIRCUIT FOR A MICROWAVE.

(H) ALL OUTLETS SERVING COUNTERTOP SURFACES ARE TO BE GFCI PROTECTED. REQUIRED OUTLETS SERVING WET BAR SINKS ARE TO BE GFCI PROJECTED WITHIN 6 FEET OF THE OUTER EDGE OF THE SINK.

(I) RECEPTACLES OUTLETS ARE REQUIRED AT ALL COUNTERTOPS 12" OR WIDER AND ARE TO BE PLACED SUCH THAT NO POINT ALONG THE WALL IS MORE THAN 24" AWAY FROM AN OUTLET.

(J) RECEPTACLE OUTLETS SHELL BE LOCATED NOT MORE THAN 20 INCHES ABOVE THE COUNTERTOP. RECEPTACLE OUTLERS SHALL NOT BE INSTALLED IN A FACE-UP POSITION IN THE WORK SURFACES OR COUNTERTOPS. RECEPTACLE OUTLETS RENDERED NOT READILY ACCESSIBLE BY APPLIANCES FASTENED IN PLACE OR APPLIANCES OCCUPYING DEDICATED SPACES AHLL NOT BE CONSIDEREDAS THESE REQUIRED OUTLETS. REQUIRED OUTLETS SHALL NOT BE INSTALLED MORE THAN 12" BELOW COUNTERTOP OR WHERE COUNTER TOP OVERHANDS MORE THAN 6".

(K) ALL LIGHT FIXTURES THAT ARE TO BE RECESSED INTO INSULATED CEILINGS SHALL BE INSULATION CONTACT (I.C) RATED. LIGHT FIXTURE HOUSING SHALL BE AIRTIGHT.

(L) ALL KITCHEN PERMANENT LIGHTING WATTAGE SHALL COME FROM HIGH EFFICACY LIGHT FIXTURES. PERMINANT FLUORESCENT LIGHTING AT ALL INDOOR ROOMS SHALL BE BY 4-PIN FLUORESCNET FIXTURES.

(M) ALL BATHROOM PERMANENT LIGHTING SHALL BE HIGH EFFICACY OR SHELL BE CONTROLLED BY A MOTION SENSOR.
7.

GREEN BUILDING REQUIREMENTS

(A) INDOOR WATER EFFICIENCY: INSTALL WATER-EFFICIENT FIXTURES AND FITTINGS PER CALGREEN 4.303. REPLACE ALL NONCOMPLIANT FIXTURES IN PROJECT AREA PER CALGREEN 3.301.1.1.

(B) ENERGY EFFICIENCY: COMPLY WITH CALIFORNIA ENERGY CODE (TITLE 24, PART 6)

(C) BATHROOM EXHAUST FANS: MUST BE ENERGYSTAR COMPLIANT, DUCTED TO TERMINATE OUTSIDE THE BUILDING AND CONTROLLED BY A HUMIDISTAT CAPABLE OF ADJUSTMENT BETWEEN RELATIVE HUMIDITY OF LESS THAN 50% TO MAXIMUM OF 80%. HUMIDITY CONTROL MAY BE SEPARATE COMPONENT FROM THE EXHAUST FAN.

(D) COMPOSITE WOOD PRODUCTS: HARDWOOD PLYWOOD, PARTICLE BOARD, AND MEDIUM DENSITY FIBERBOARD COMPOSITE WOOD PRODUCTS USED ON INTERIOR OR EXT. SHALL MEET CARB AIR TOXICS CONTROL MEASURE FOR COMPOSITE WOOD.

(E) INTERIOR PAINTS AND COATINGS: COMPLY WITH VOC LIMITS IN THE AIR RESOURCES BOARD ARCHITECTURAL COATINGS SUGGESTED CONTROL MEASURE AND CALIFORNIA CODE OF REGULATIONS TITLE 17 FOR AEROSOL PAINTS.

(F) LOW VOC CAULKS, CONSTRUCTION ADHESIVES, AND SEALANTS: SCAQMD RULE 1168.

LEGEND

	EXISTING WALL TO REMAIN		WALL RECEPTACLE ±18" A.F.F. MAX U.N.O
	EXISTING WALL TO BE REMOVED		GFCI WALL RECEPTACLE ±42" A.F.F.
	(N) INTERIOR 2X PARTITION WALL		WALL SWITCH ±42" A.F.F., 48" A.F.F MAX
	(N) INTERIOR 1-HR. PARTITION WALL (1 LAYER OF 5/8" TYPE X GYP. BD. EACH SIDE, W/ R-13 INSUL.)		VENTILATION FAN
	(N) INSULATION R-13 INSULATION (SEE DETAIL 1/A3.0)		FLUORESCENT LIGHTING FIXTURE
	SMOKE DETECTOR 110V. W/ BACK-UP POWER		TELEPHONE/DATA JACK ±18" A.F.F. MAX U.N.O
	CARBON MONOXIDE ALARM		SHEET NOTE REFERENCE

SHEET NOTES

1.

PROVIDE 1/2" TYPE X GYP. BOARD ON GARAGE CEILING.
2.

PROVIDE 20-MIN. SELF CLOSING SOLID CORE DOOR
3.

PROVIDE VENTILATION FAN, SEE GENERAL NOTE 6D.

DESIGNER:
LCF SOLUTIONS INC.
FELIX LIU 415.517.4448



RESIDENTIAL ADDITION

338 TEDDY AVENUE
SAN FRANCISCO, CA 94134

ISSUEDDATE

PROJECT TITLE
RESIDENTIAL
ADDITION

338 TEDDY AVENUE
SAN FRANCISCO, CA 94134


FILE NO.
DRWN BY: SHERYLL
DATE : 07/25/2021
CHK'D BY F.LIU
PROJ. NO. 2111
SCALE 1/4" = 1'-0"

SHEET DESCRIPTION


EXISTING &
PROPOSED
FLOOR
PLANS

SHEET NO.


A1.0

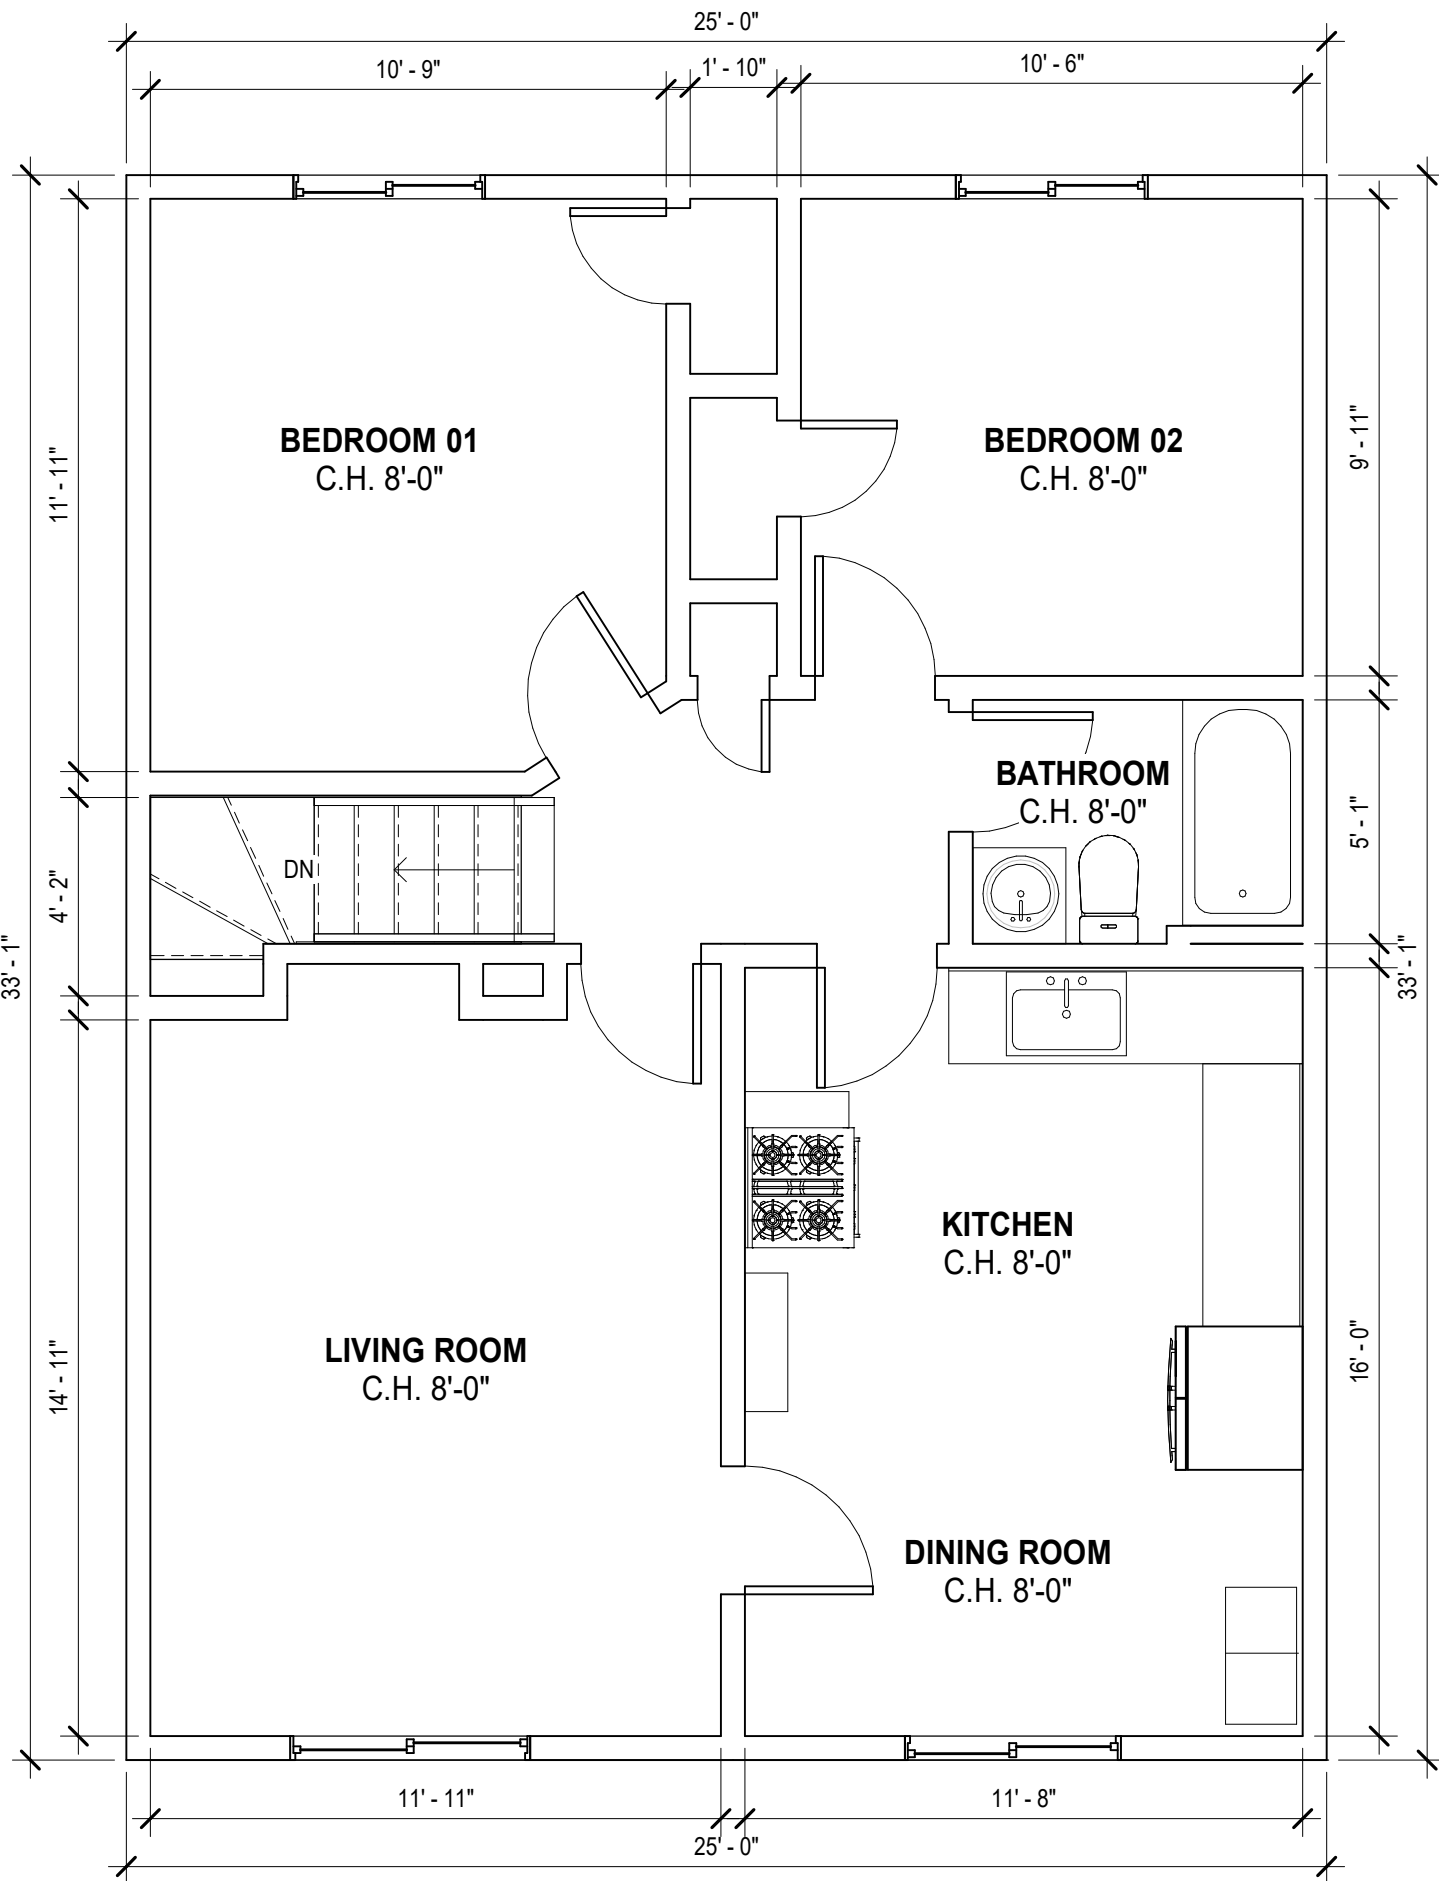

1 EXISTING 2ND FLOOR PLAN
1/4" = 1'-0"

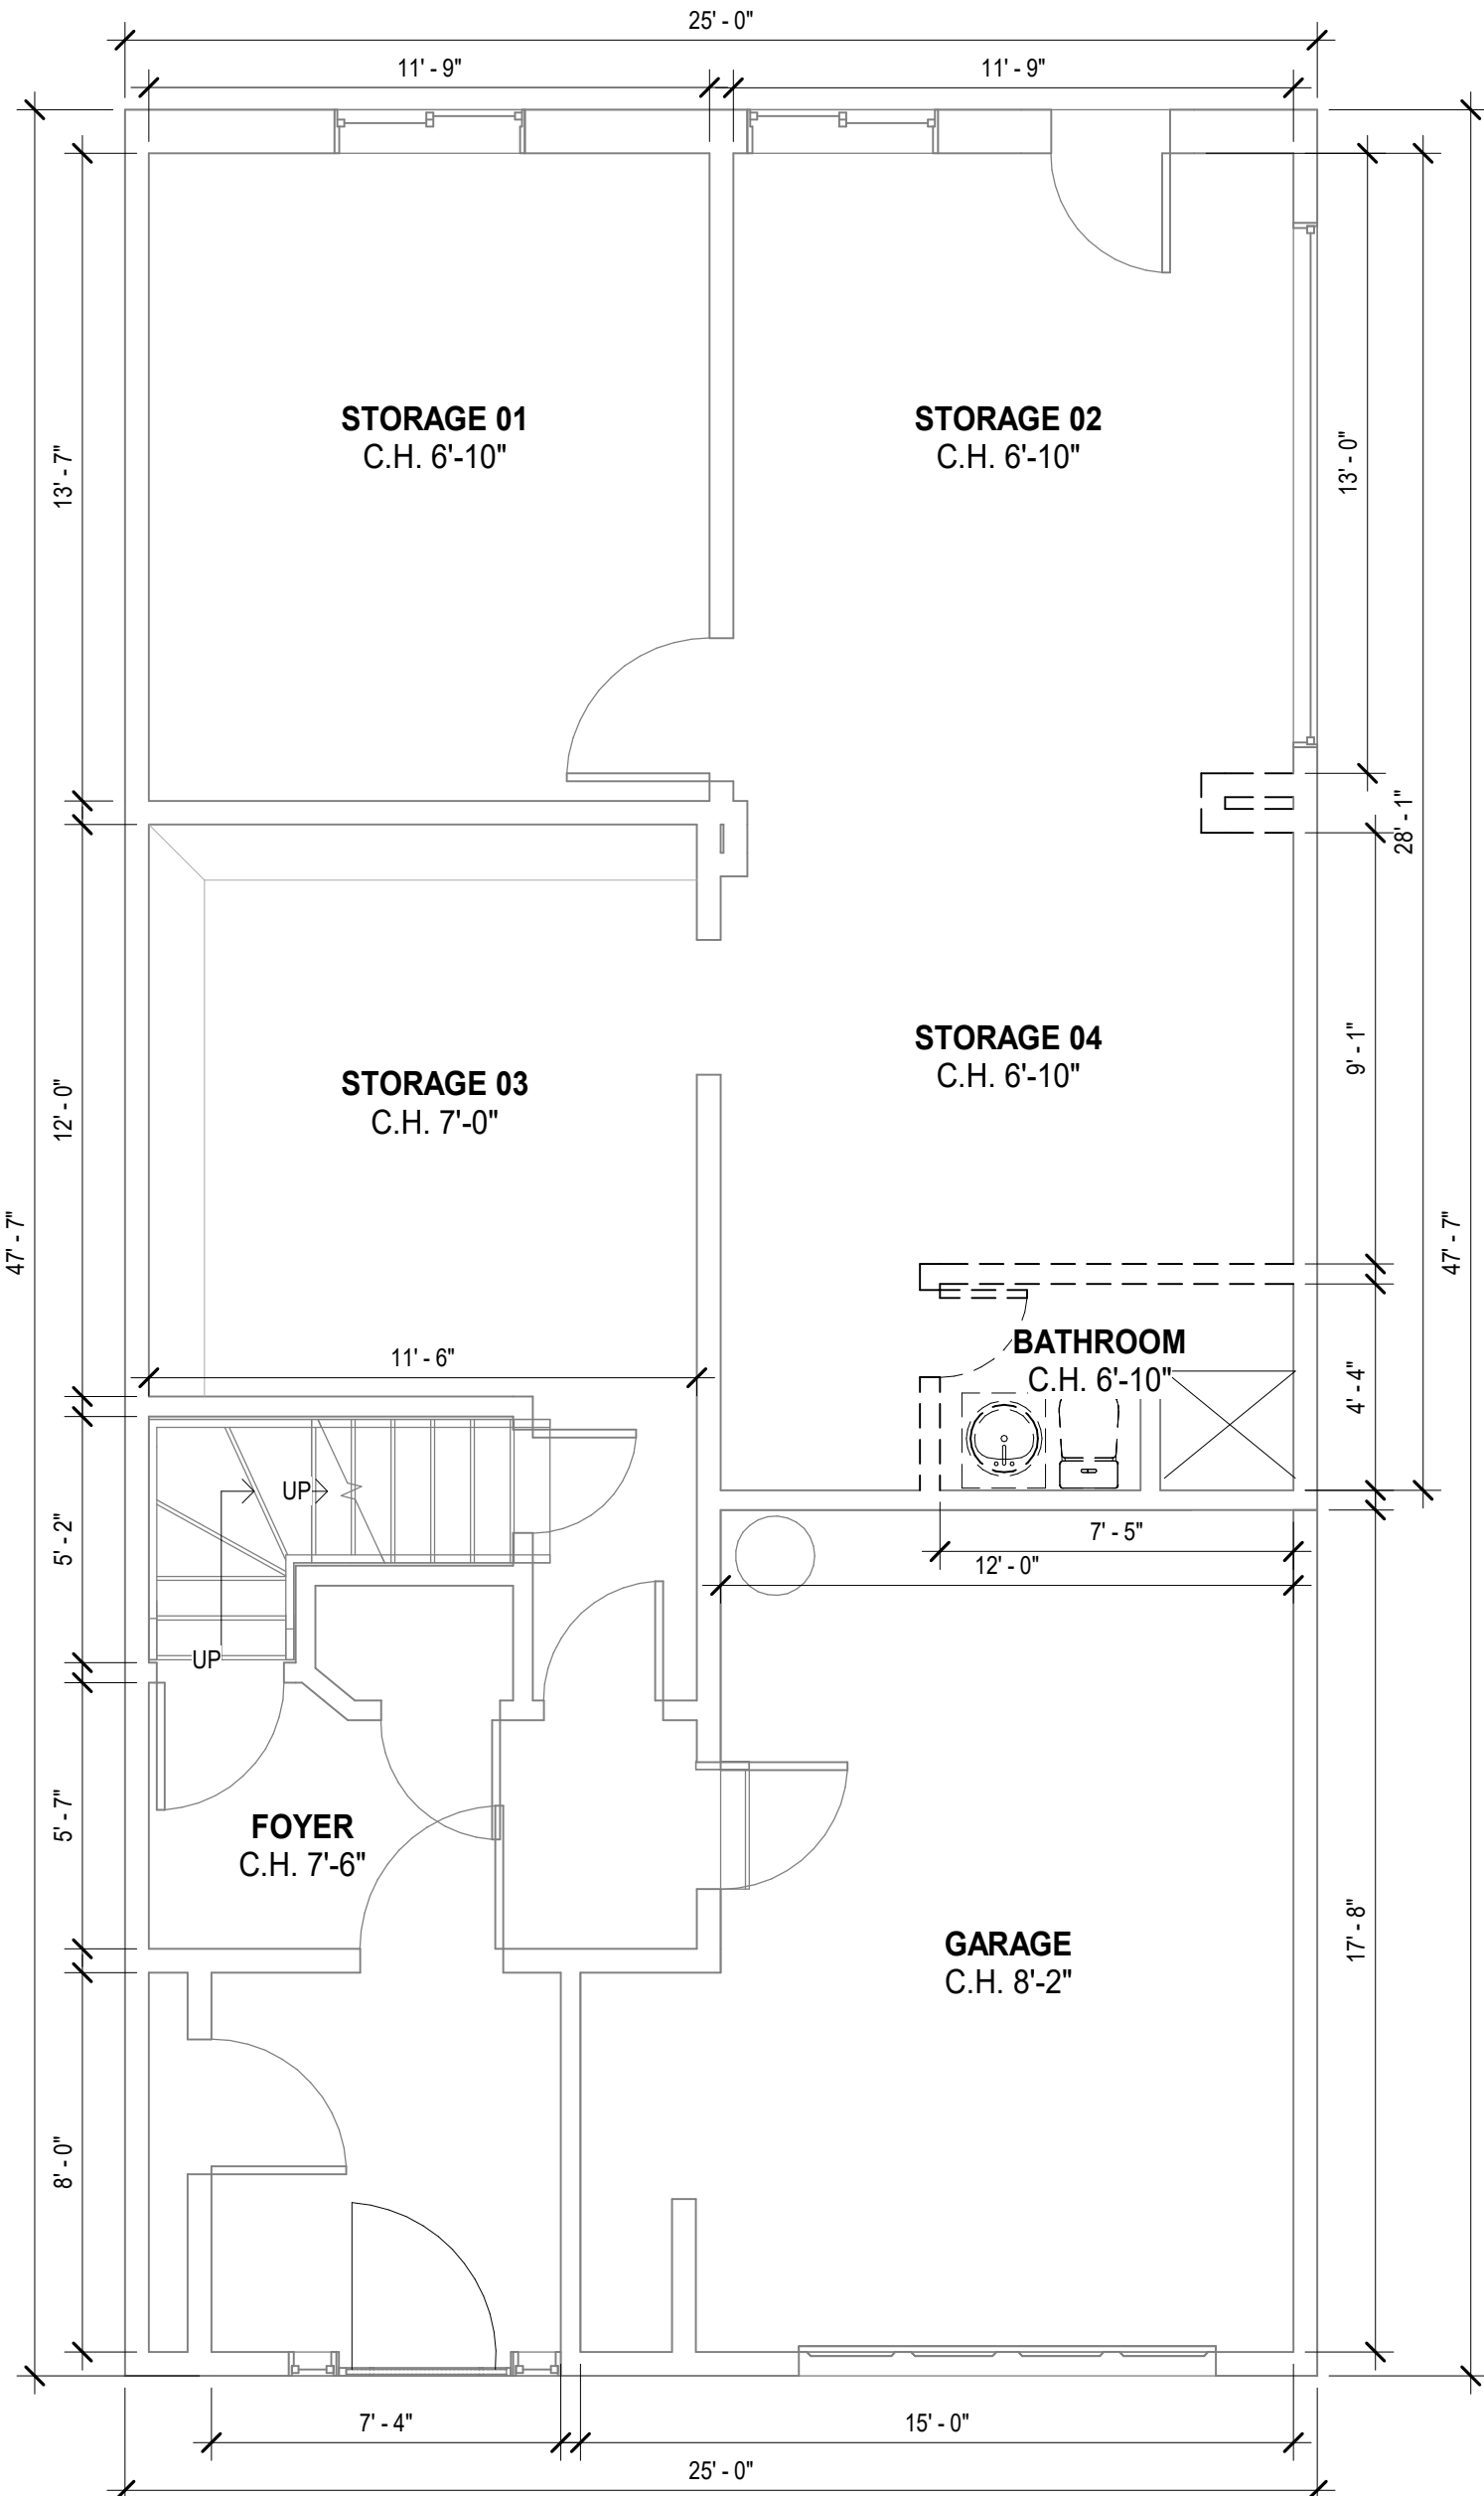

2 EXISTING GROUND FLOOR PLAN
1/4" = 1'-0"

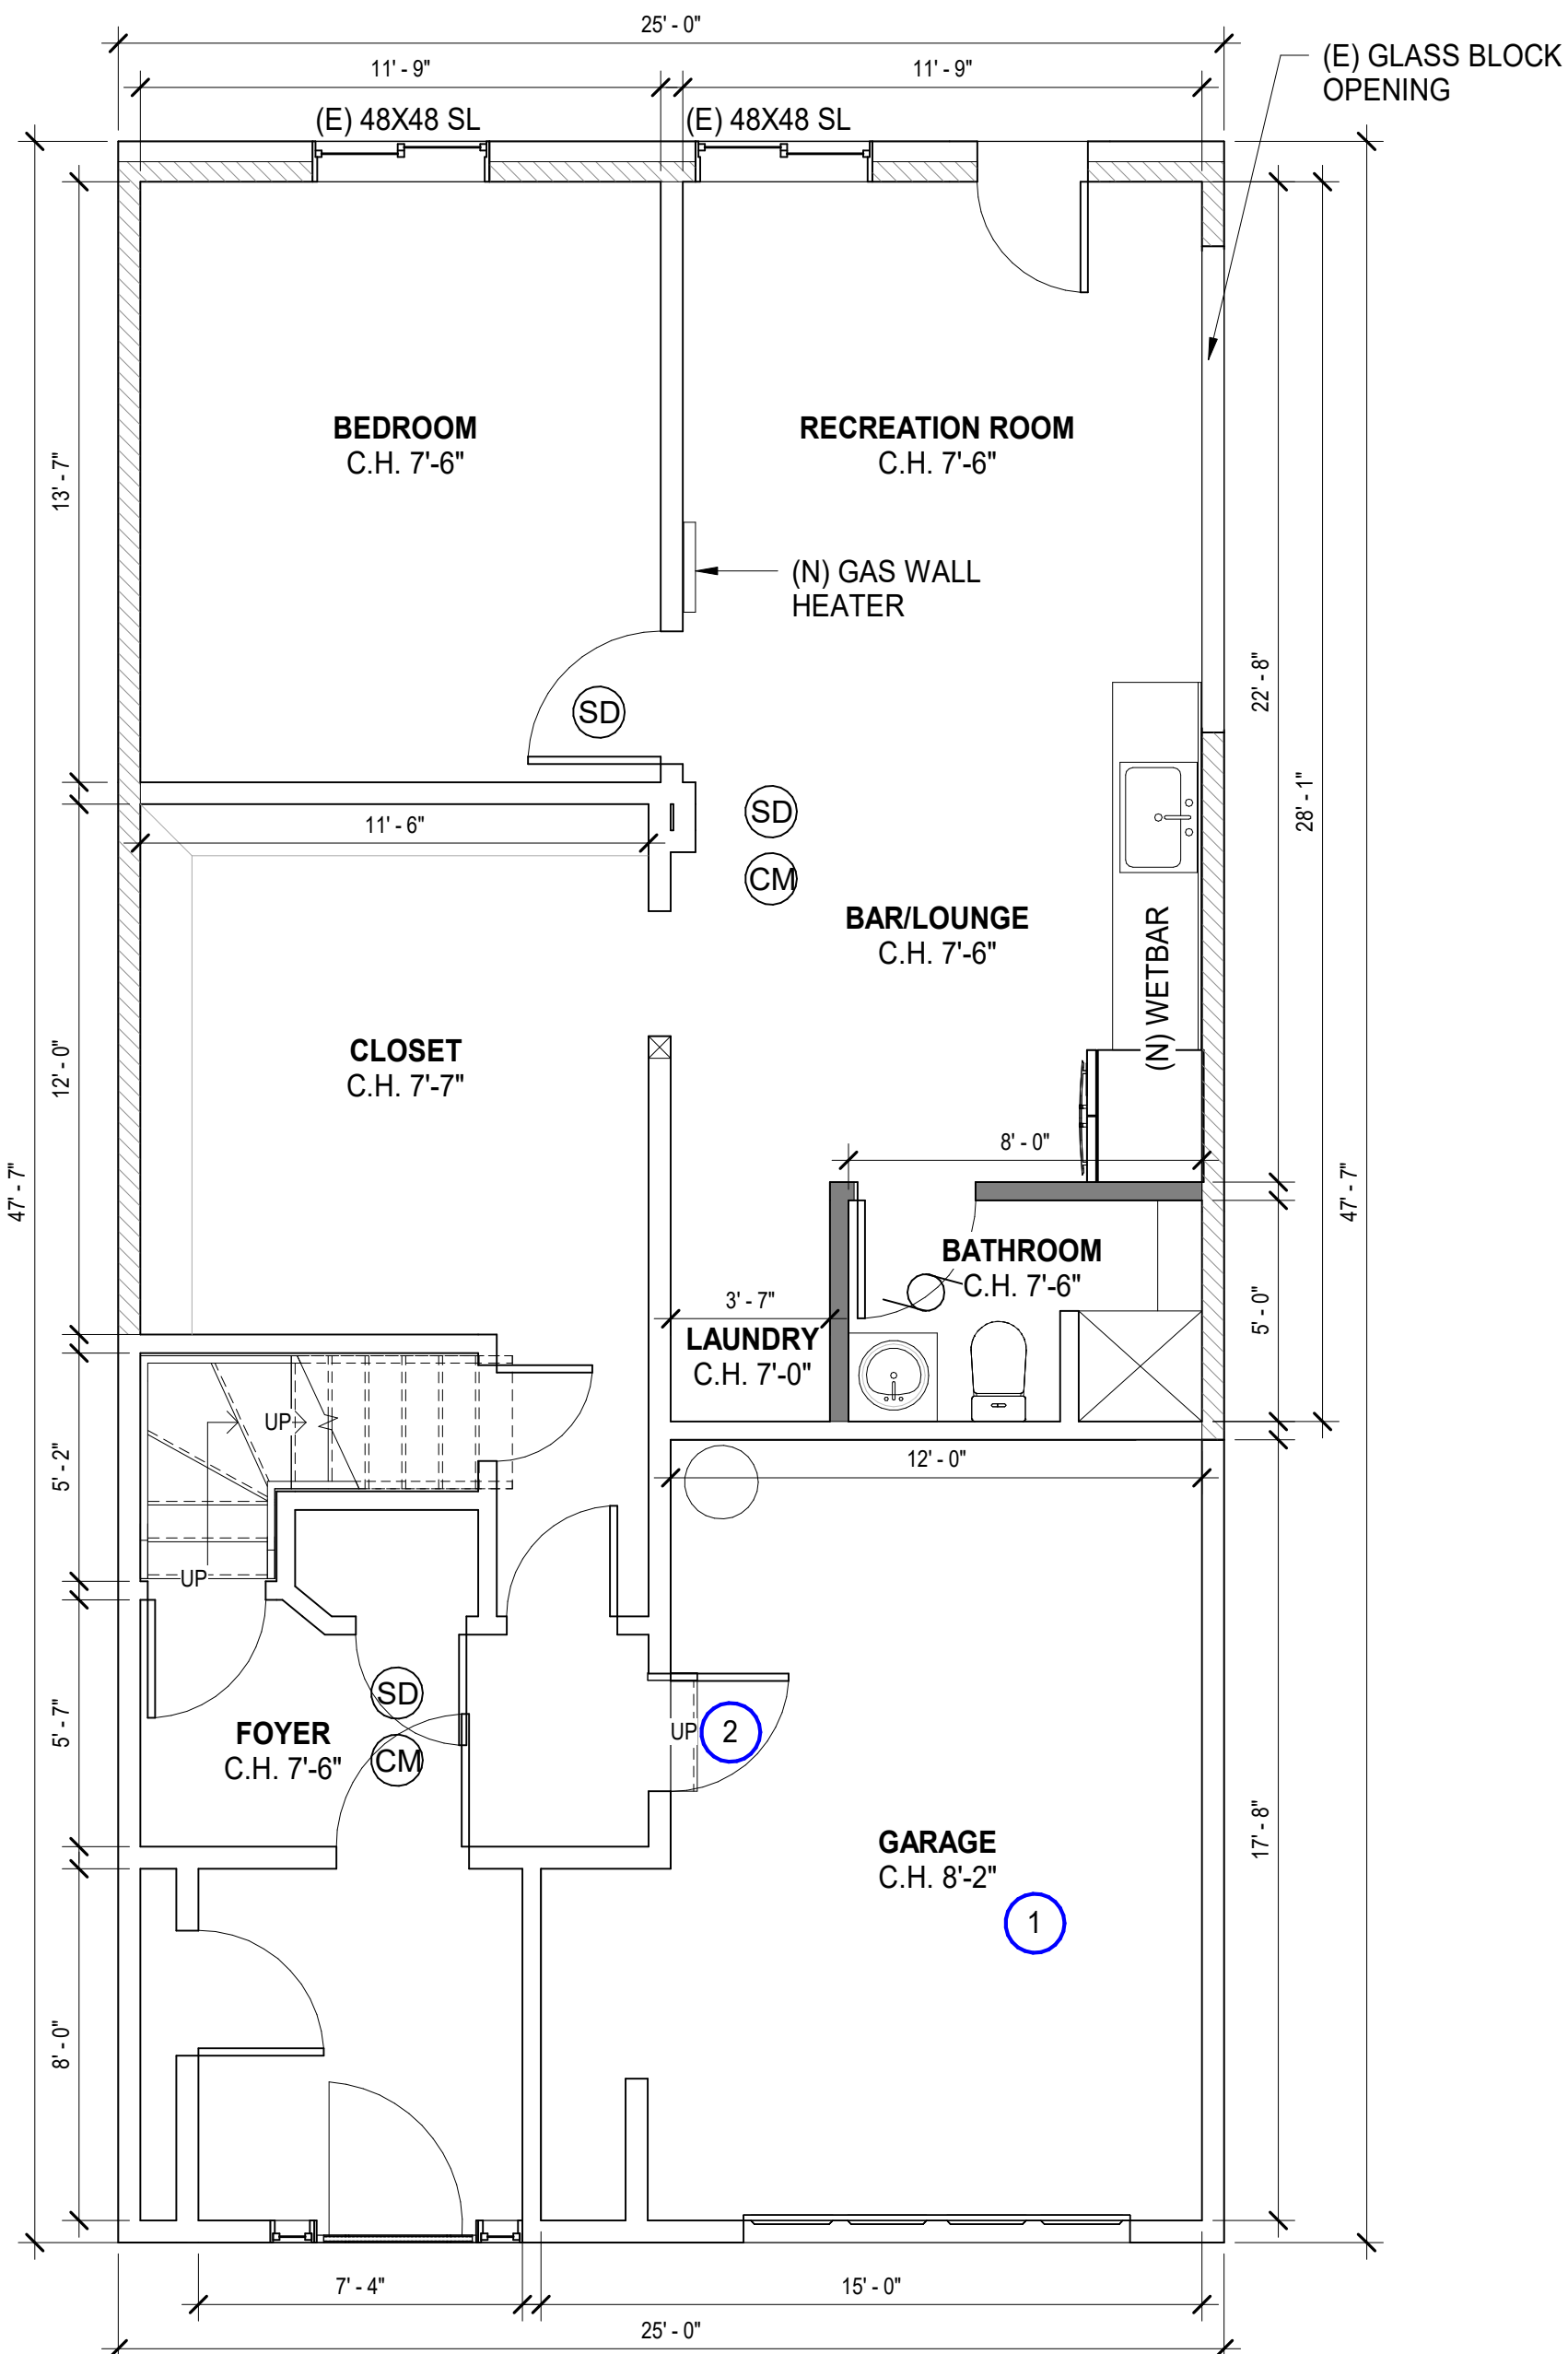


3 PROPOSED GROUND FLOOR PLAN
1/4" = 1'-0"

GENERAL NOTES


1. PROVIDE A MINIMUM OF TWO 20-AMP CIRCUITS TO SUPPLY THE COUNTER TOP RECEPTABLES.
2. DISHWASHER, GARBAGE DISPOSALS AND OTHER BUILT IN APPLIANCES REQUIRED DEDICATED CIRCUIT.
3. ALL RECEPTABLES ALONG COUNTER TOPS ARE REQUIRED TO BE GFCI PROTECTED AND BE LOCATED NO FARTHER THAN 4FT APART.
4. AT LEAST 50% OF INSTALLED LUMINAIRES WATTAGE MUST BE OF HIGH EFFICACY (H.E.) LIGHTING AND MUST BE SWITCHED SEPARATELY FROM NON-H.E. LIGHTING.
5. FOR KITCHEN, BATHROOMS, LAUNDRY, UTILITY ROOMS AND GARAGES: PROVIDE A FLOURESCENT FIXTURE, OR PROVIDE A MANUAL ON / OCCUPANCY SENSOR CONTROL (NO DIMMER).
6. FOR ALL OTHER ROOMS: PROVIDE FLOURESCENT FIXTURES, OR PROVIDE OCCUPANCY SENSORS OR DIMMERS.
7. ALL RECESSED LIGHT FIXTURES INSTALLED IN INSULATED CEILINGS SHALL BE IC (INSULATION COVER) AND AT (AIR TIGHT) RATED.

LEGEND

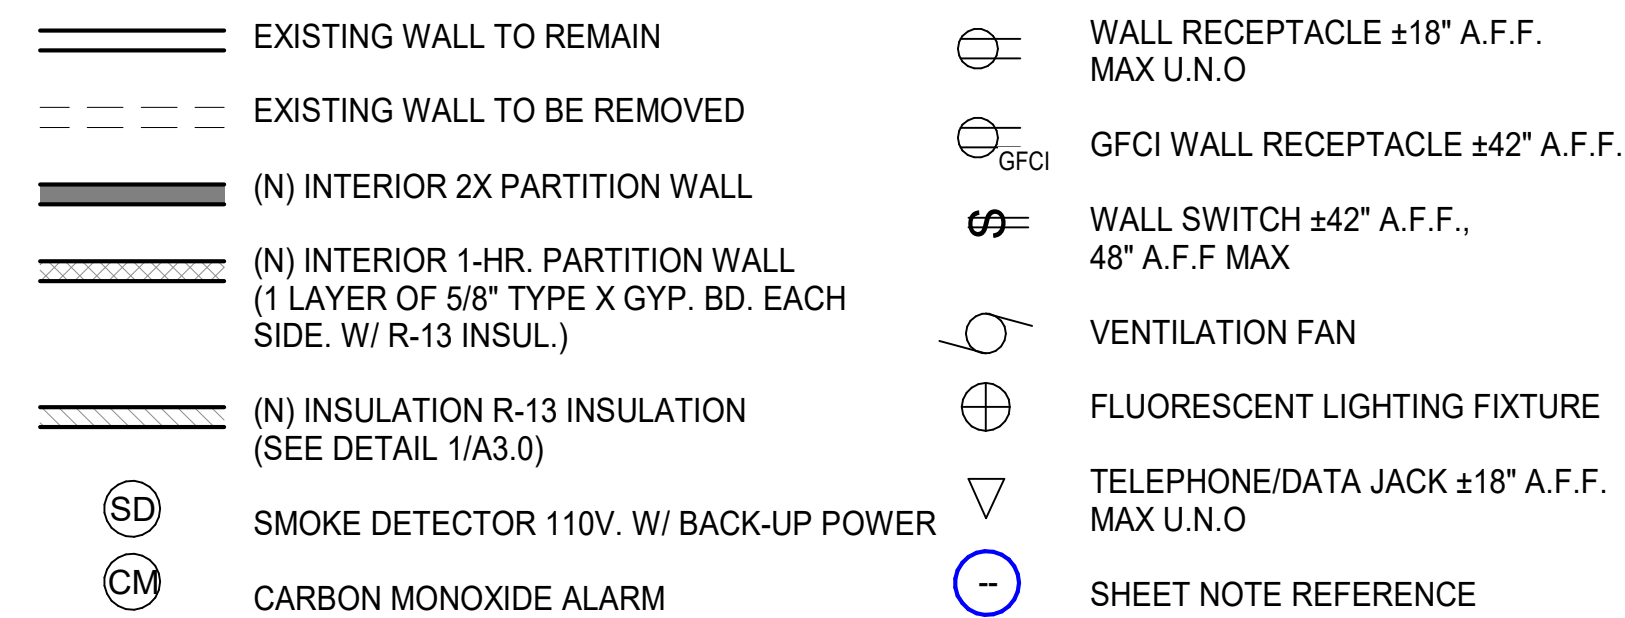


SHEET NOTES

DESIGNER:
LCF SOLUTIONS INC.
FELIX LIU 415.517.4448

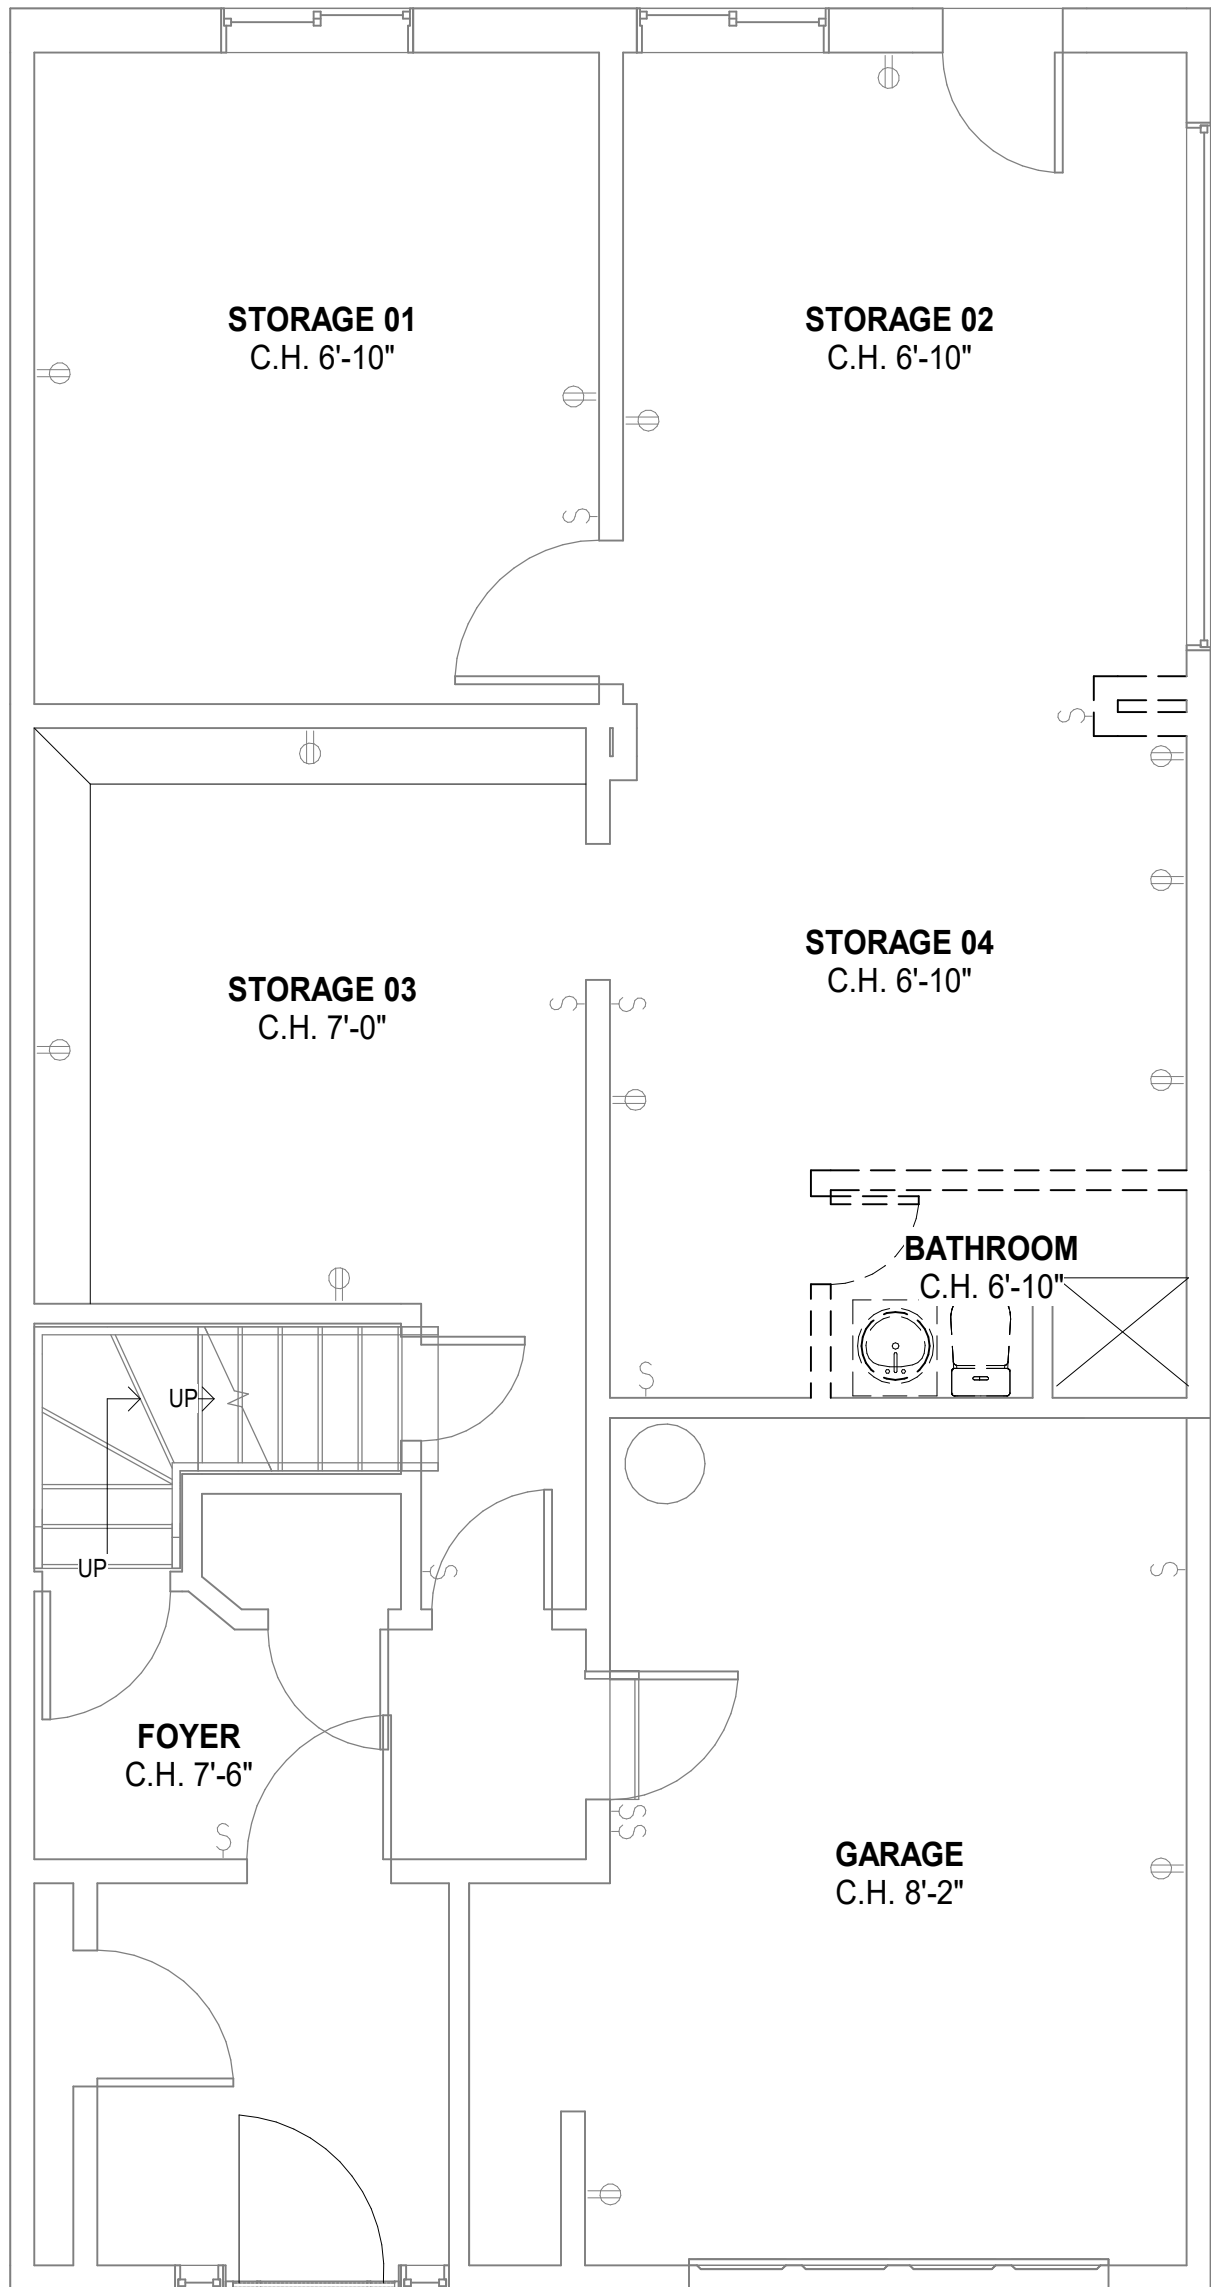The logo for LCF solutions, featuring the letters "LCF" in orange and "solutions" in grey, with a small orange graphic above the "s".

1 (E) GROUND FLOOR POWER LAYOUT
1/4" = 1'-0"

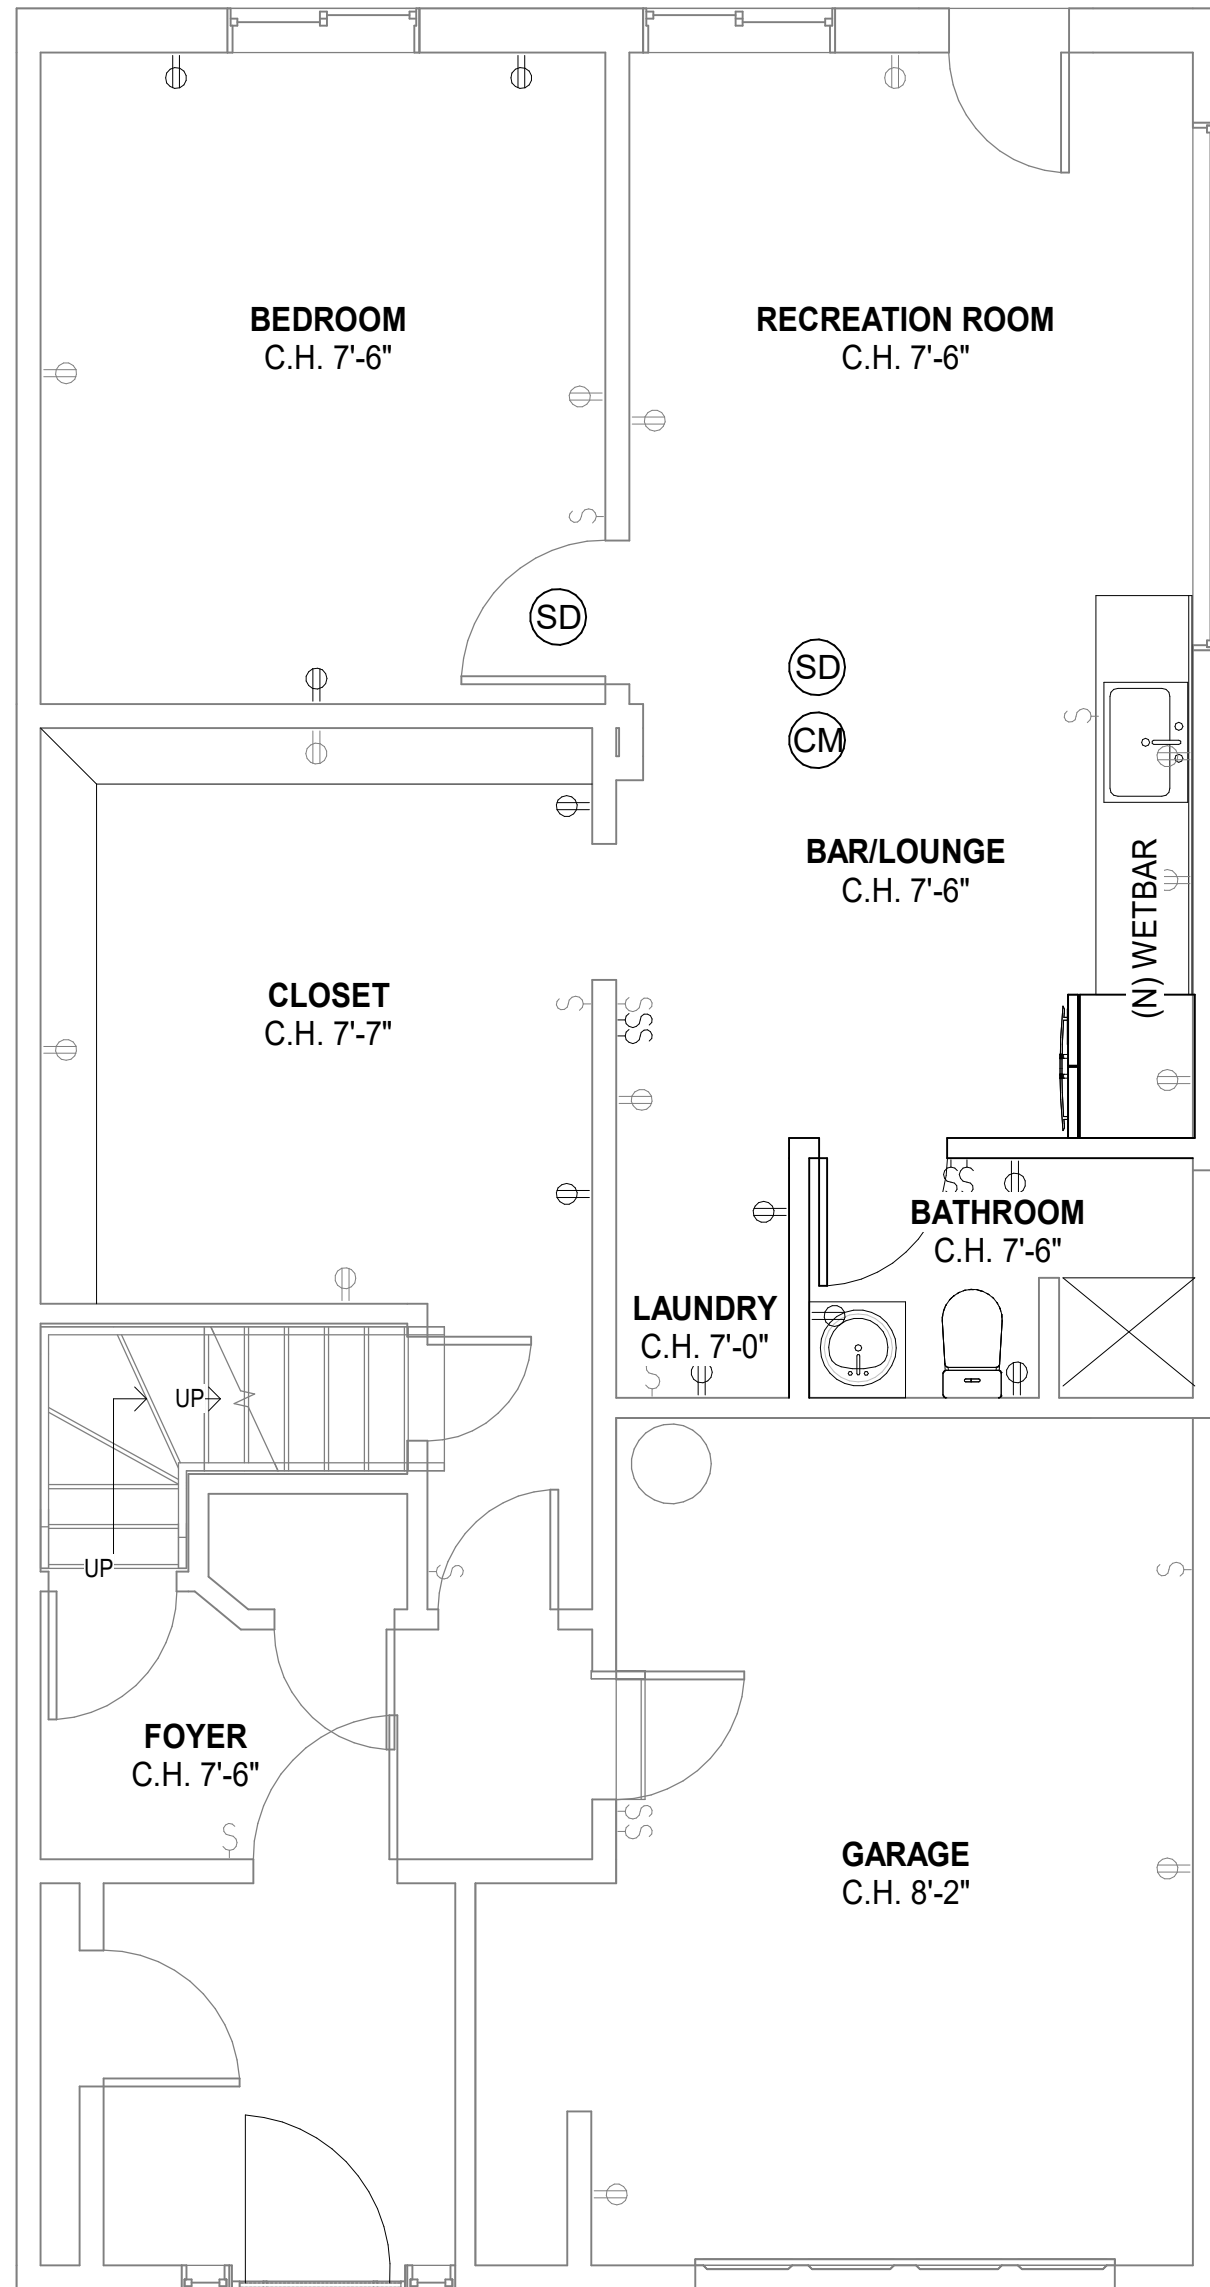

2 (N) GROUND FLOOR LAYOUT PLAN
1/4" = 1'-0"

RESIDENTIAL ADDITION

338 TEDDY AVENUE
SAN FRANCISCO, CA 94134

[illegible]

PROJECT TITLE
**RESIDENTIAL
ADDITION**

338 TEDDY AVENUE
SAN FRANCISCO, CA 94134

FILE NO.	
DRWN BY:	F.LIU
DATE :	09/18/21
CHK'D BY	KJ.YEO
PROJ. NO.	2111
SCALE	1/4" = 1'-0"

SHEET DESCRIPTION















**EXISTING &
PROPOSED
POWER
LAYOUT**

SHEET NO.
E1.0

GENERAL NOTES

1. PROVIDE A MINIMUM OF TWO 20-AMP CIRCUITS TO SUPPLY THE COUNTER TOP RECEPTABLES.
2. DISHWASHER, GARBAGE DISPOSALS AND OTHER BUILT IN APPLIANCES REQUIRED DEDICATED CIRCUIT.
3. ALL RECEPTABLES ALONG COUNTER TOPS ARE REQUIRED TO BE GFCI PROTECTED AND BE LOCATED NO FARTHER THAN 4FT APART.
4. AT LEAST 50% OF INSTALLED LUMINAIRES WATTAGE MUST BE OF HIGH EFFICACY (H.E.) LIGHTING AND MUST BE SWITCHED SEPARATELY FROM NON-H.E. LIGHTING.
5. FOR KITCHEN, BATHROOMS, LAUNDRY, UTILITY ROOMS AND GARAGES: PROVIDE A FLOURESCENT FIXTURE, OR PROVIDE A MANUAL ON / OCCUPANCY SENSOR CONTROL (NO DIMMER).
6. FOR ALL OTHER ROOMS: PROVIDE FLOURESCENT FIXTURES, OR PROVIDE OCCUPANCY SENSORS OR DIMMERS.
7. ALL RECESSED LIGHT FIXTURES INSTALLED IN INSULATED CEILINGS SHALL BE IC (INSULATION COVER) AND AT (AIR TIGHT) RATED.

LEGEND

	EXISTING WALL TO REMAIN		WALL RECEPTACLE ±18" A.F.F. MAX U.N.O
	EXISTING WALL TO BE REMOVED		GFCI WALL RECEPTACLE ±42" A.F.F.
	(N) INTERIOR 2X PARTITION WALL		WALL SWITCH ±42" A.F.F., 48" A.F.F MAX
	(N) INTERIOR 1-HR. PARTITION WALL (1 LAYER OF 5/8" TYPE X GYP. BD. EACH SIDE. W/ R-13 INSUL.)		VENTILATION FAN
	(N) INSULATION R-13 INSULATION (SEE DETAIL 1/A3.0)		FLUORESCENT LIGHTING FIXTURE
	SMOKE DETECTOR 110V. W/ BACK-UP POWER		TELEPHONE/DATA JACK ±18" A.F.F. MAX U.N.O
	CARBON MONOXIDE ALARM		SHEET NOTE REFERENCE

SHEET NOTES

DESIGNER:
LCF SOLUTIONS INC.
FELIX LIU 415.517.4448



RESIDENTIAL ADDITION

338 TEDDY AVENUE
SAN FRANCISCO, CA 94134

ISSUED	DATE

PROJECT TITLE**RESIDENTIAL
ADDITION**

338 TEDDY AVENUE
SAN FRANCISCO, CA 94134

FILE NO.

DRWN BY: F.LIU

DATE : 09/18/21

CHK'D BY KJ.YEO


PROJ. NO. 2111

SHEET DESCRIPTION


EXISTING & PROPOSED LIGHTING LAYOUT

SHEET NO.



E1.1

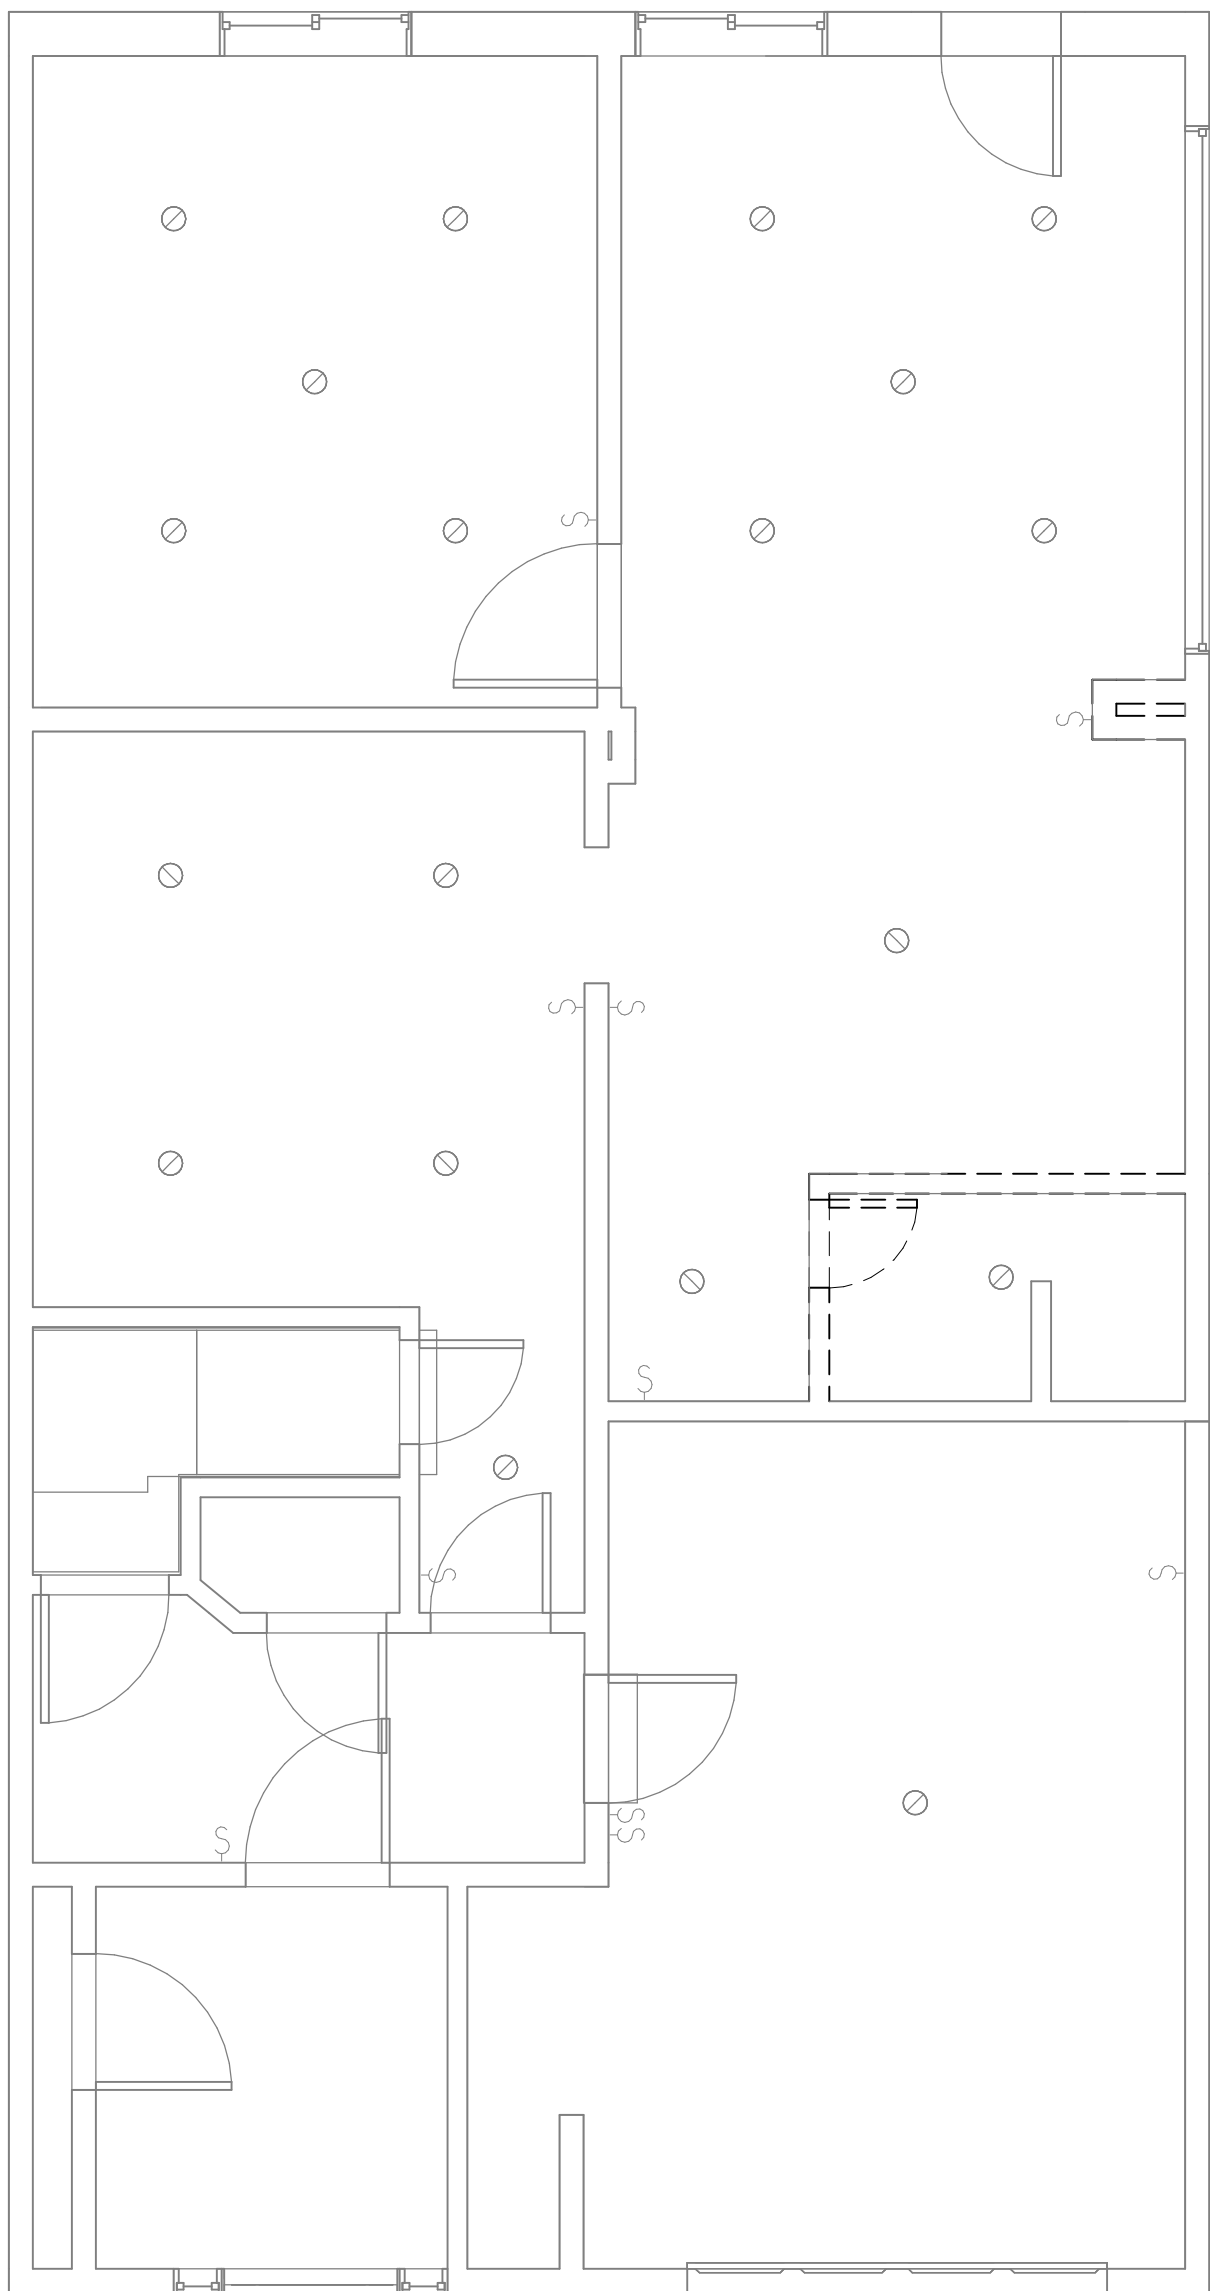



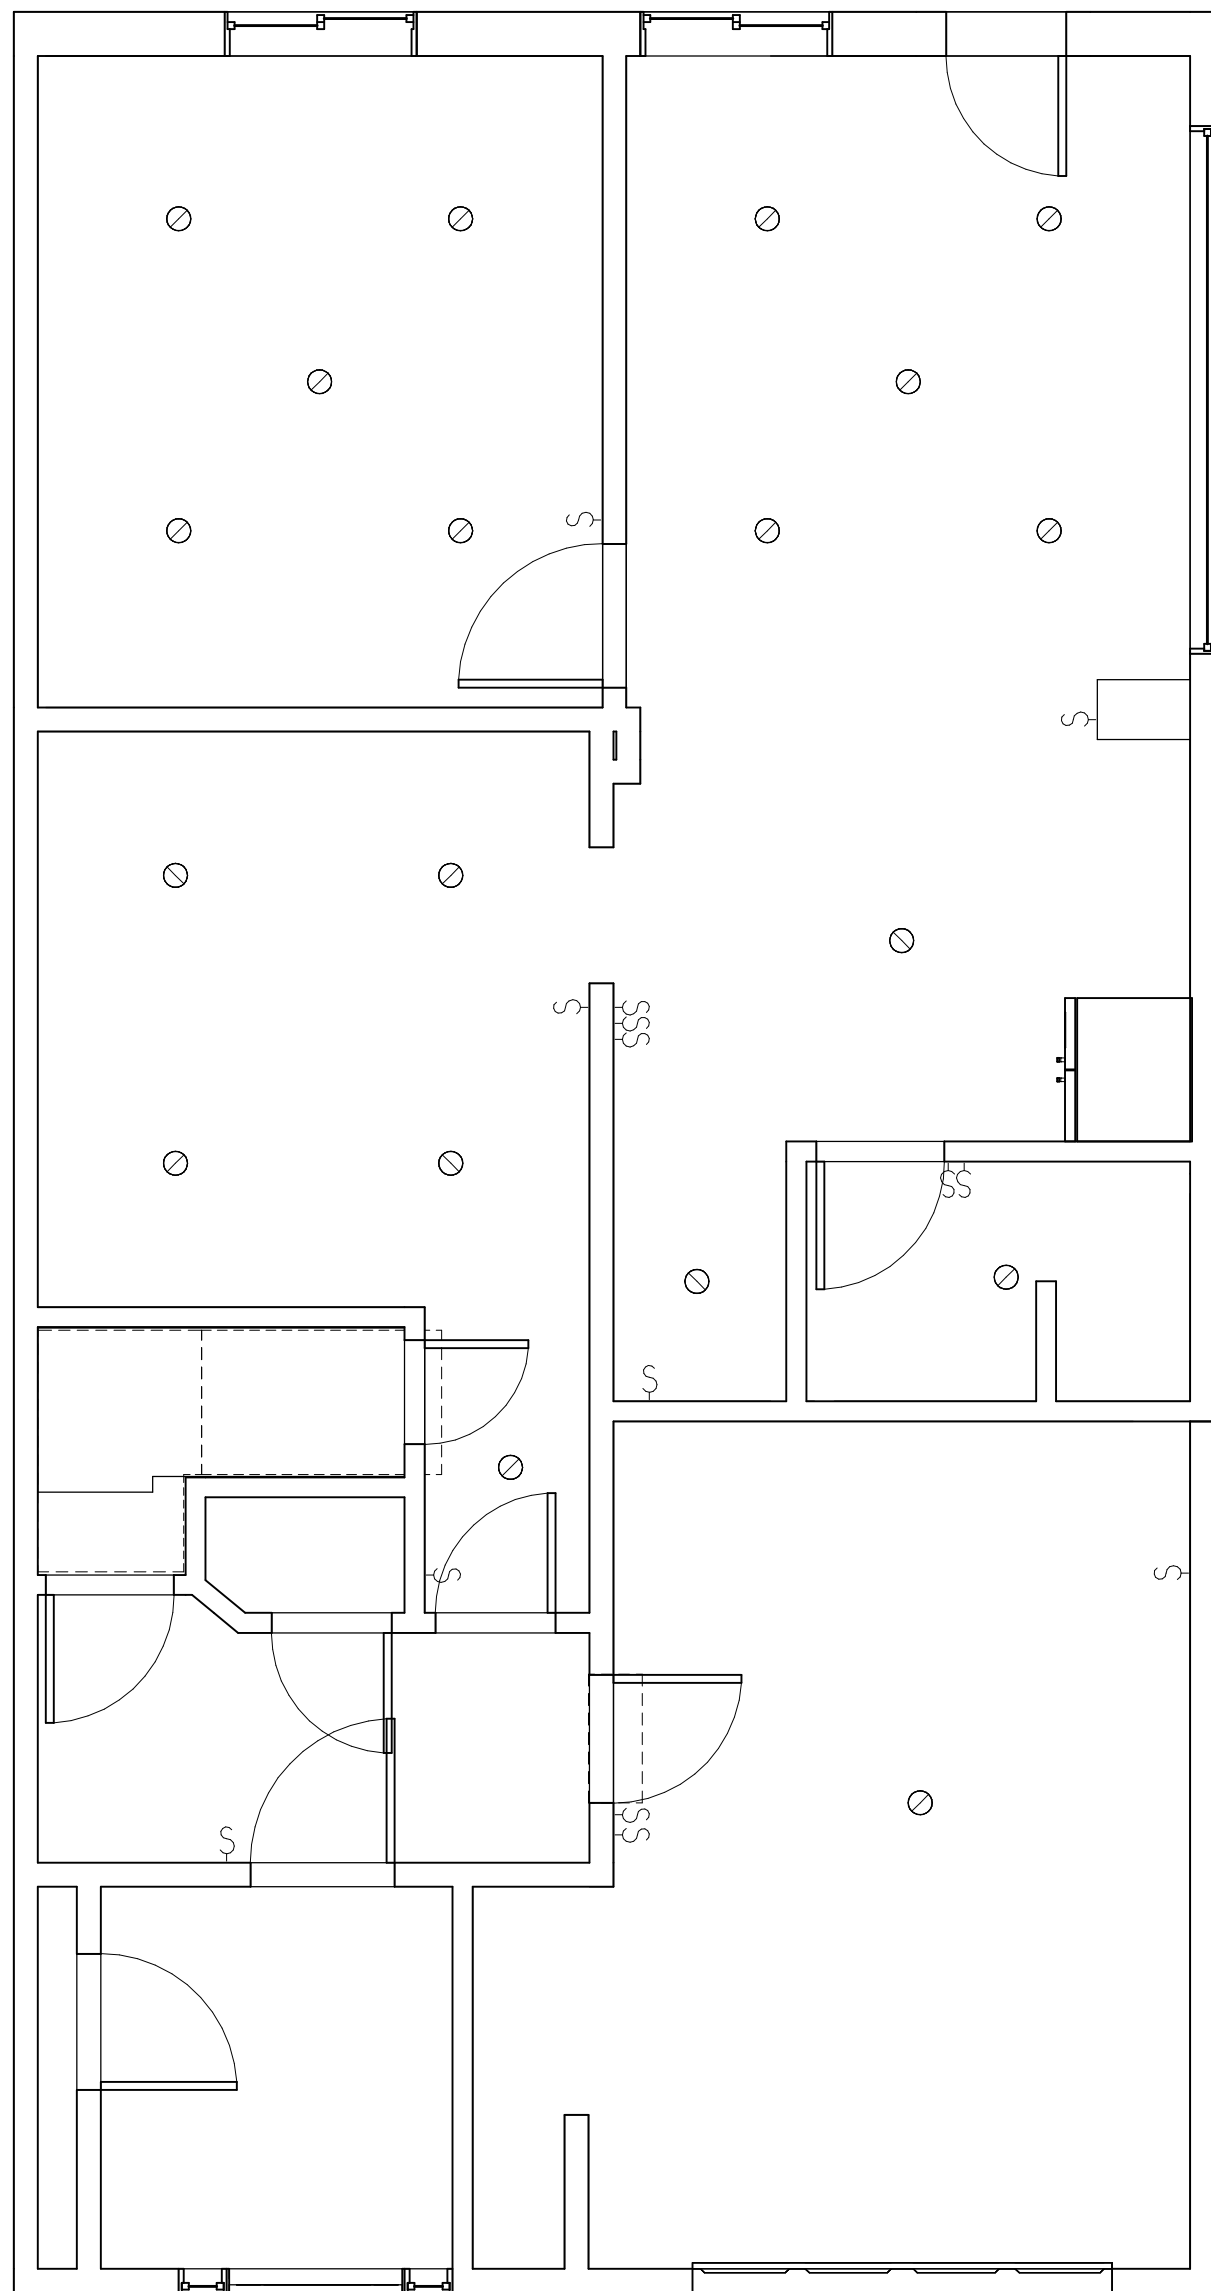

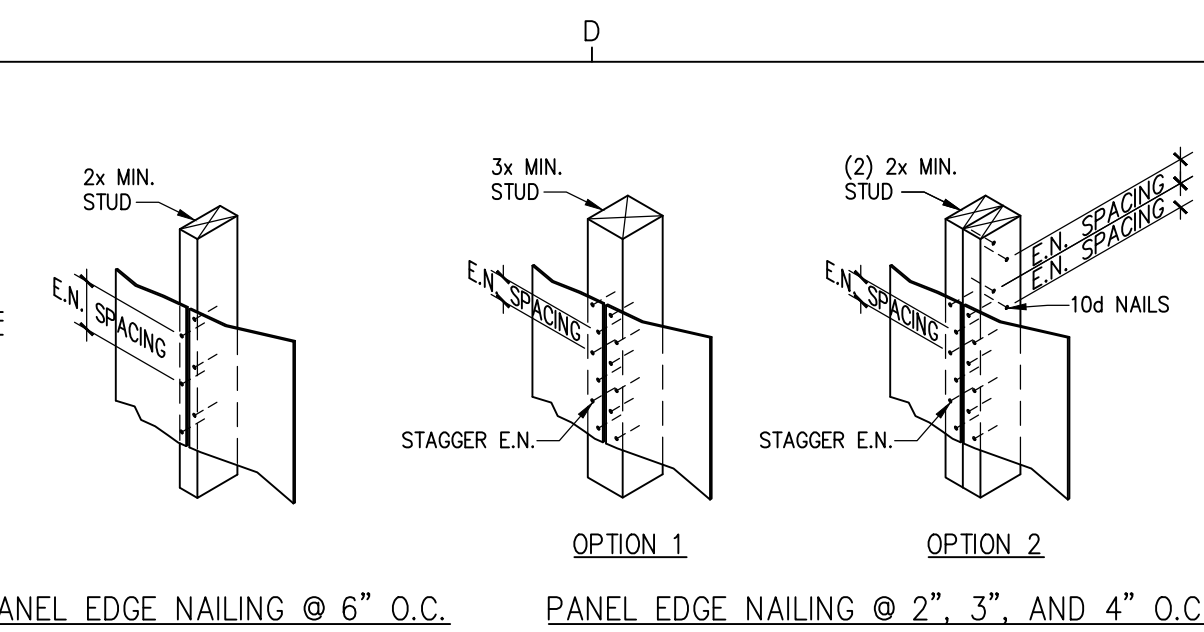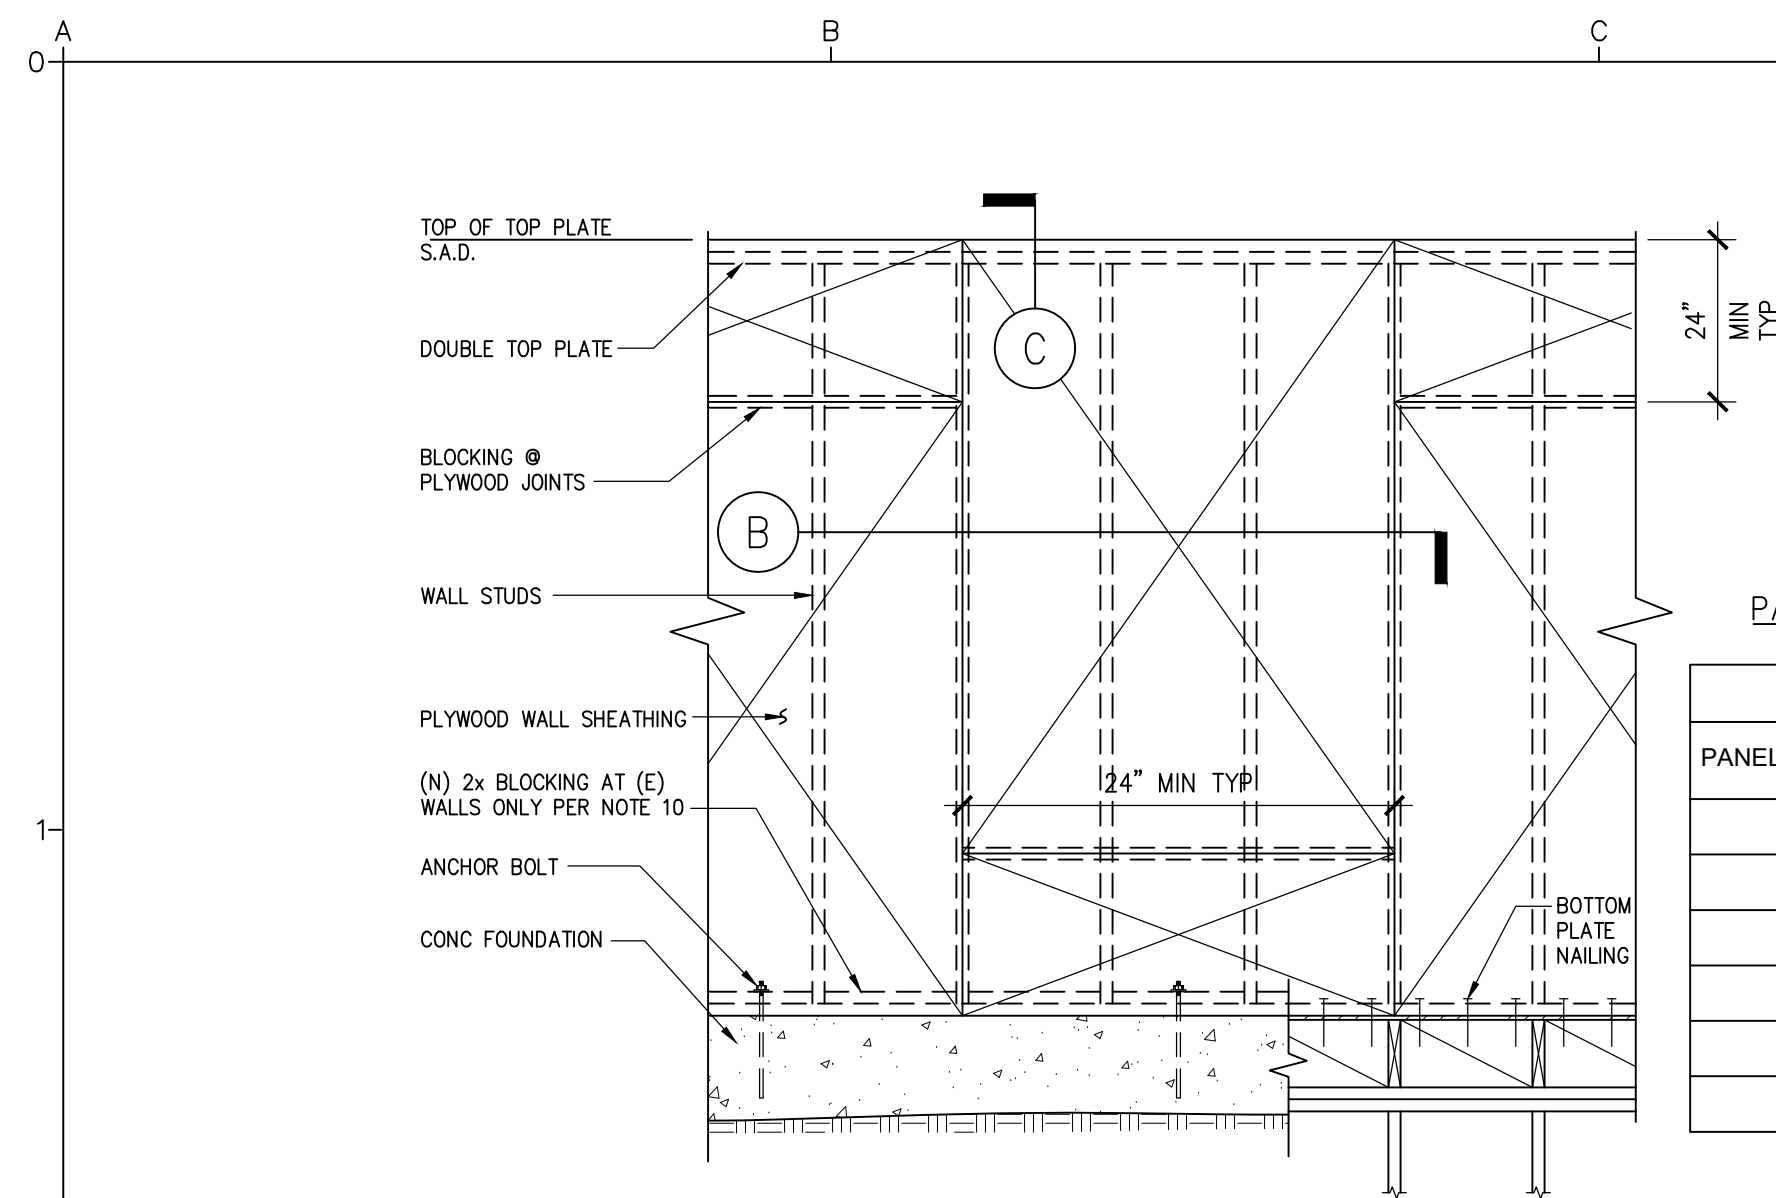

1 (E) GROUND FLOOR RCP
1/4" = 1'-0"







② (N) GROUND FLOOR RCP
1/4" = 1'-0"




SHEAR WALL SCHEDULE									
PANEL DESIGNATION	STRUCTURAL I PLYWOOD SHEATHING	PANEL EDGE NAILING	FIELD NAILING	BOTTOM PLATE FASTENING TO RIM JOIST @ UPPER STORIES	SILL ANCHOR @ FOUNDATION	TRANSFER CLIP	TOP PLATE FASTENING	HOLDOWN ⁶	TIE-DOWN
	15/32"	10d @ 6" O.C.	10d @ 12" O.C.	10d FOR 2x PLATE OR 5" SDWS @ 8" O.C.	5/8" DIA. @ 32" O.C., 7" MIN EMBED	A35 @ 16" O.C.	20d OR 5" SDWS ⁵ SDWS @ 8" O.C.	HDU2	SEE APPLICABLE TIE-DOWN DETAIL
	15/32"	10d @ 4" O.C.	10d @ 12" O.C.	16d @ 5" O.C. FOR 2x PLATE OR 5" SDWS @ 8" O.C.	5/8" DIA @ 16" O.C., 7" MIN EMBED	A35 @ 8" O.C.	20d @ 5" O.C. OR 5" SDWS @ 8" O.C.	HDU4	SEE APPLICABLE TIE-DOWN DETAIL
	15/32"	10d @ 3" O.C.	10d @ 12" O.C.	5" SDWS @ 8" O.C.	5/8" DIA @ 16" O.C., 7" MIN EMBED	A35 @ 8" O.C.	5" SDWS @ 8" O.C.	HDU5	SEE APPLICABLE TIE-DOWN DETAIL
	15/32"	10d @ 2" O.C.	10d @ 10" O.C.	5" SDWS @ 6" O.C.	5/8" DIA @ 12" O.C., 7" MIN EMBED	A35 @ 8" O.C.	5" SDWS @ 6" O.C.	HDU5	SEE APPLICABLE TIE-DOWN DETAIL
	15/32"	10d @ 2" O.C.	10d @ 10" O.C.	5" SDWS @ 4" O.C.	5/8" DIA @ 7" O.C., 7" MIN EMBED	A35 @ 4.5" O.C.	5" SDWS @ 4" O.C.	HDU8	SEE APPLICABLE TIE-DOWN DETAIL
	EXISTING WALL USED TO RESIST SHEAR IN STRUCTURAL CALCULATIONS								

NOTES:

- 1) MINIMUM NAIL PENETRATION IN FRAMING AND BLOCKING SHALL BE 1 3/8".
- 2) ALL PLYWOOD PANELS SHALL BE A MINIMUM OF 24" WIDE.
- 3) USE ONE PIECE PLYWOOD SHEET AT ALL SHEARWALL 48" OR LESS IN WIDTH.
- 4) ALL PANEL EDGES SHALL BE BLOCKED WITH 2x OR WIDER BLOCKING AT ALL PANEL EDGES.
- 5) KEEP MINIMUM 1/16" CLEAR BETWEEN ALL PLYWOOD PANEL EDGES.
- 6) ALL FASTENERS SHALL BE HOT DIPPED GALVANEAL (MEETING ASTM A153) AND CONNECTORS (ASTM A653 CLASS G185 SHEET), OR BETTER.
- 7) USE EITHER TOP PLATE NAILING OR TRANSFER CLIPS TO FASTEN TOP PLATES TO JOIST/BLOCKING.
- 8) USE EITHER BOTTOM PLATE NAILING OR TRANSFER CLIPS TO CONNECT SHEARWALL ABOVE TO SHEARWALL BELOW. WHEN FASTENING TO WALL ABOVE WITH TRANSFER CLIPS, USE 8d x 2 1/2" LONG NAILS ON TOP LEG OF TRANSFER CLIPS.
- 9) PROVIDE HOLD DOWNS PER SCHEDULE UNLESS SHOWN OTHERWISE IN PLAN.
- 10) PROVIDE 2x BLOCKING OVER SILL AT (E) WALLS WHERE: A) (E) SILL PLATE IS LESS THAN 3x THICK; AND/OR B) WHERE (E) SILL PLATE IS WIDER THAN STUDS.

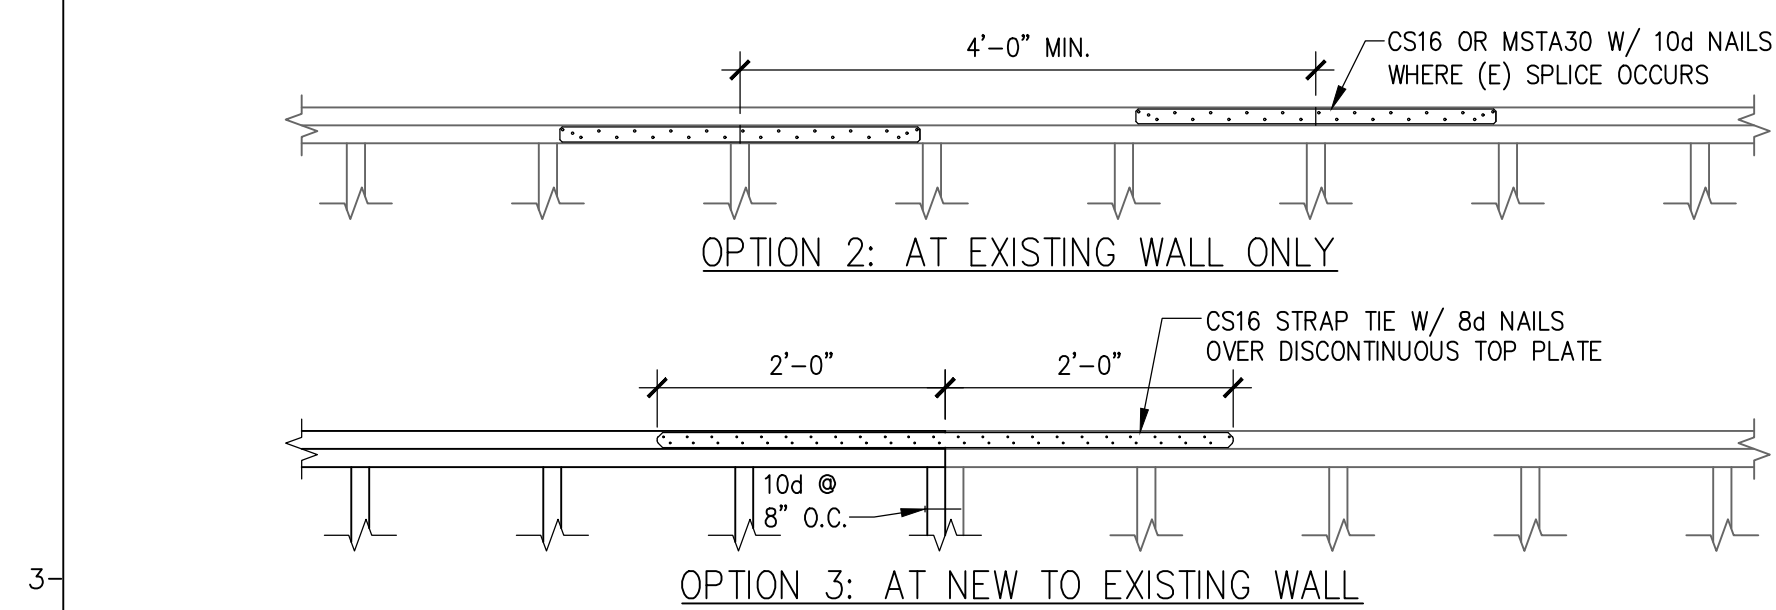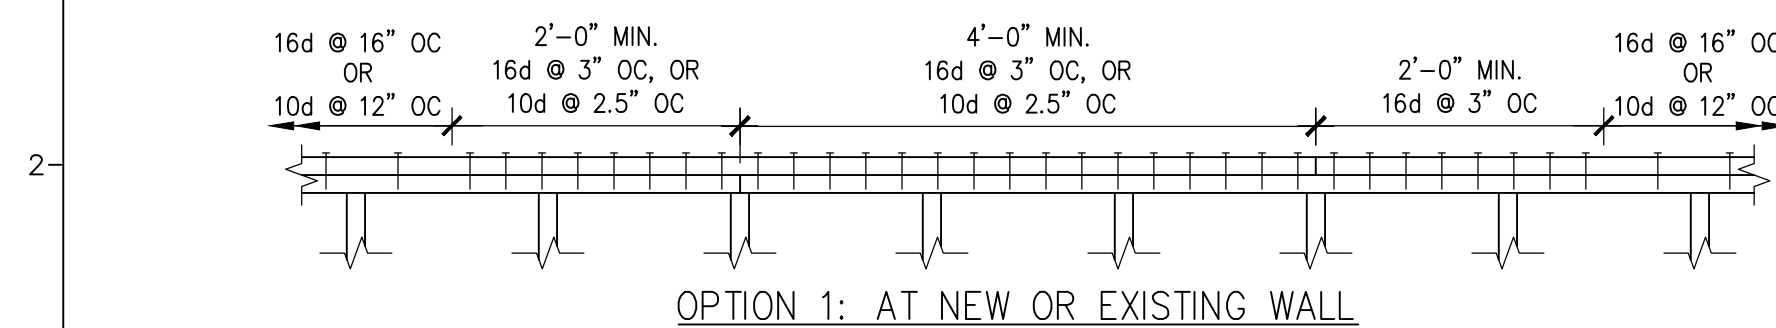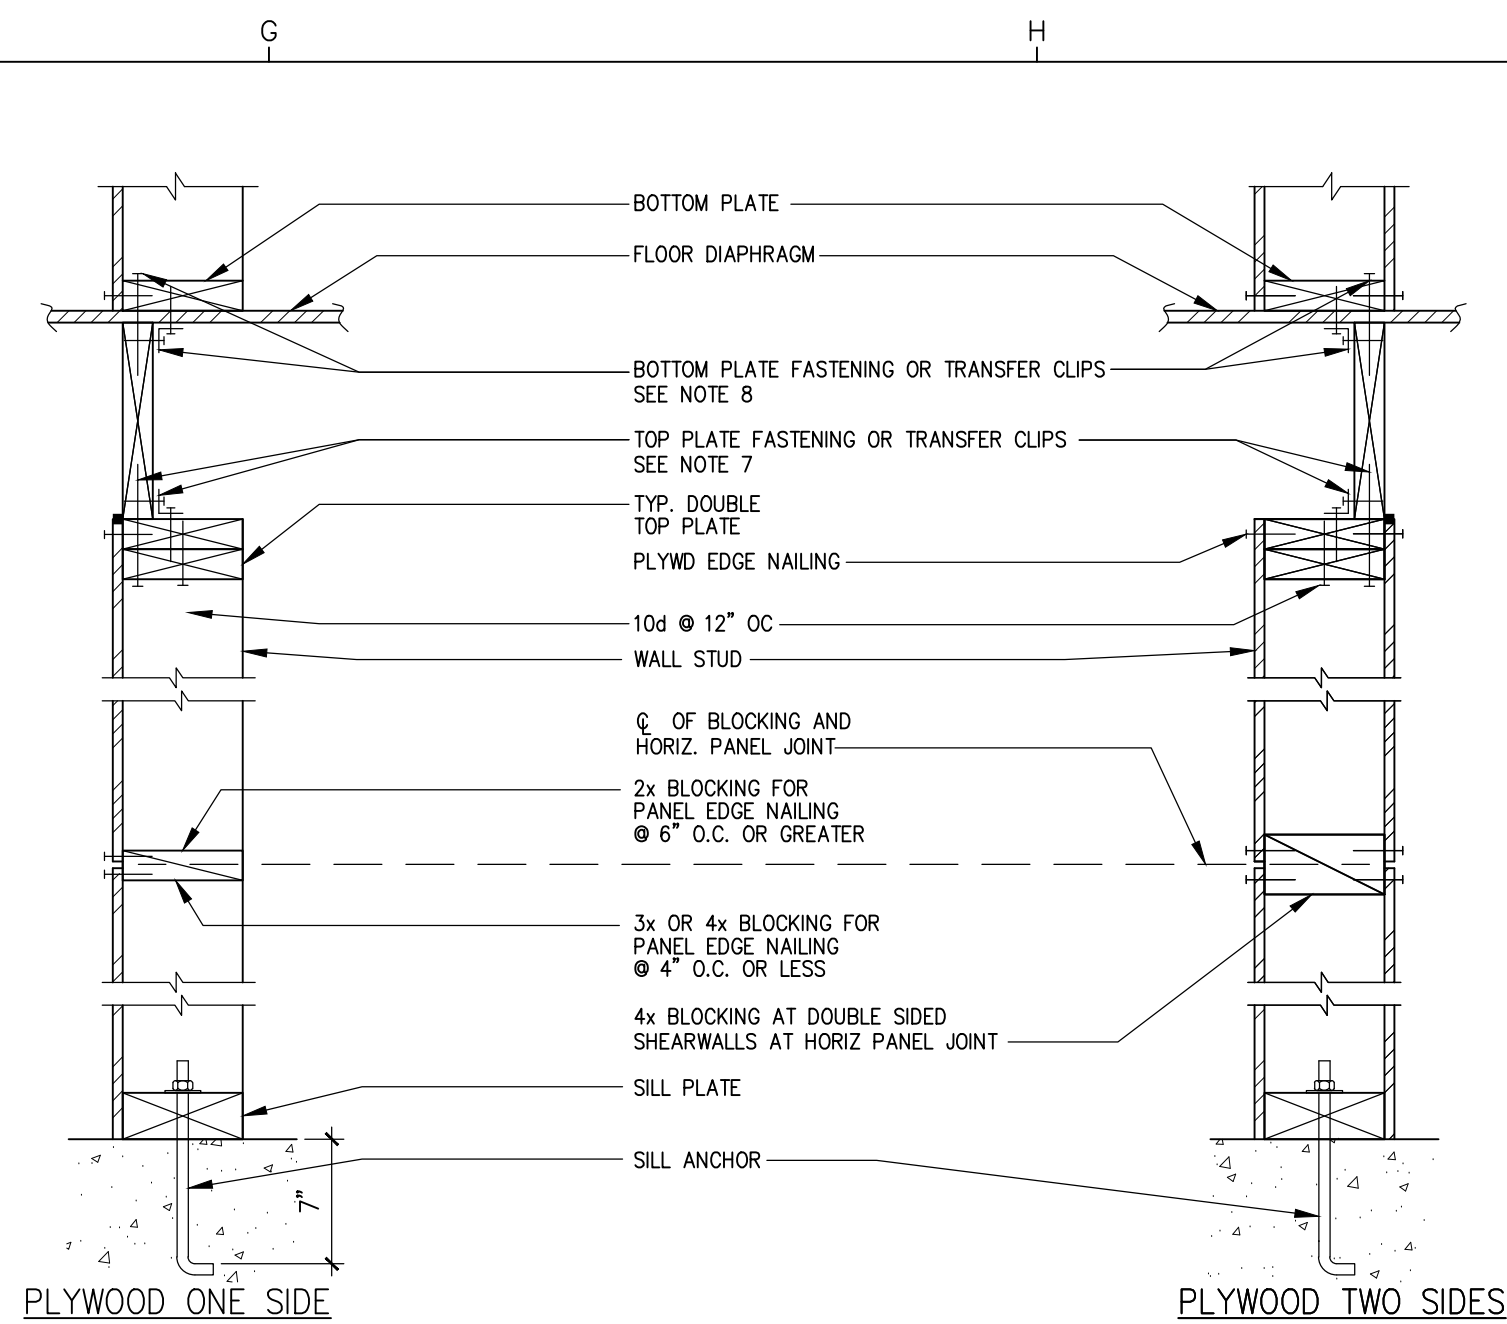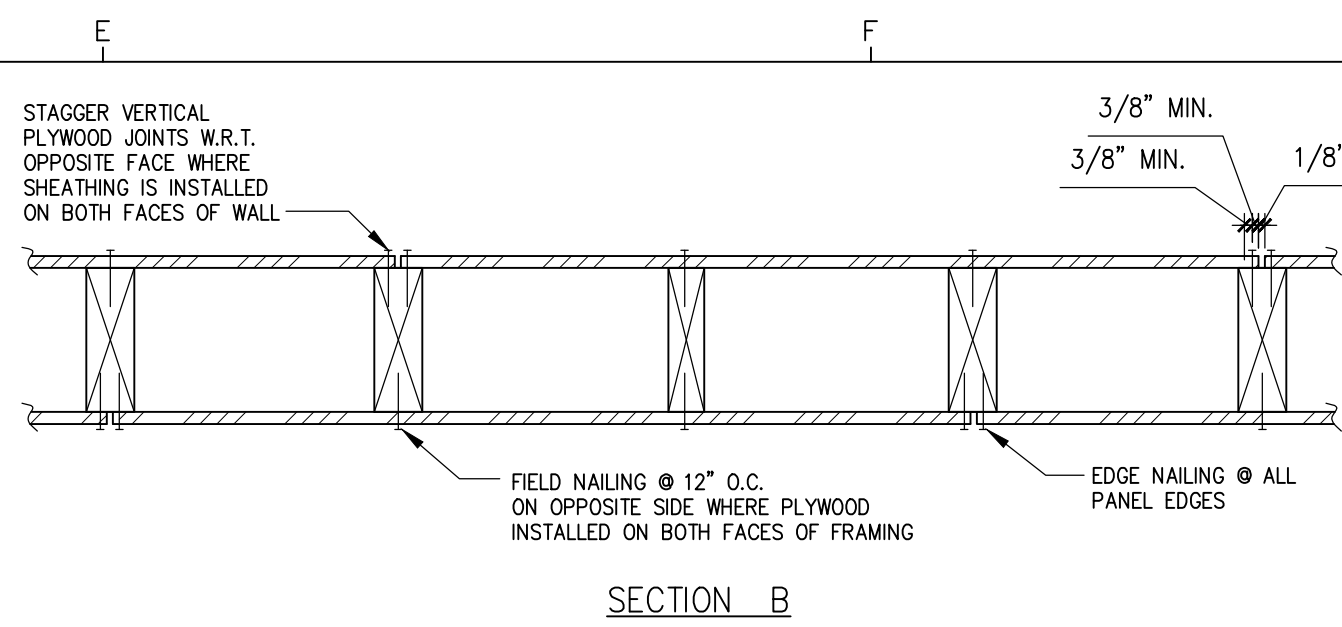

TYP DOUBLE TOP PLATE SPLICE AT SHEAR AND NON-SHEAR WALLS

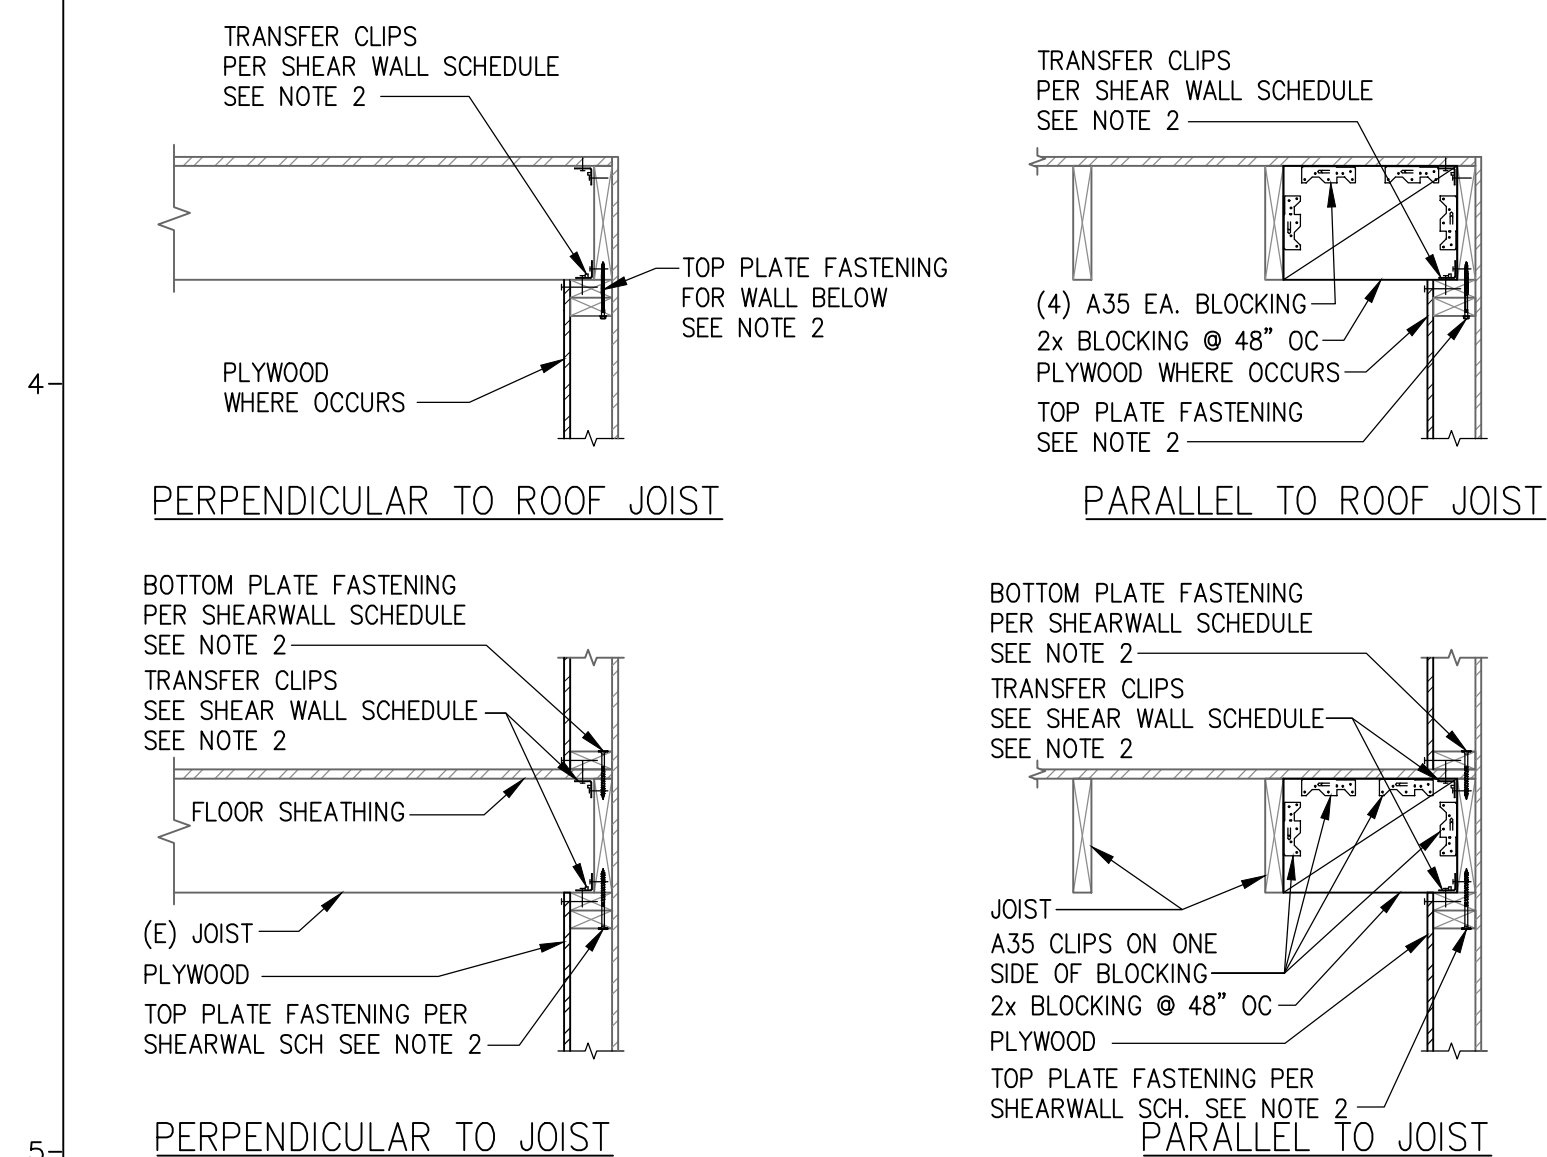


PERPENDICULAR TO JOIST

NOTES:

- 1) FASTEN A35 AND TRANSFER CLIPS TO FLOOR DIAPHRAGM ABOVE W/ #8 3/4" SCREWS AT UPPER LEG IF NOT DIRECTLY BELOW WALL. FASTEN A35 CLIPS AND TRANSFER CLIPS WITH 8d x 1 1/2" LONG NAILS ELSEWHERE.
- 2) USE EITHER TOP/BOTTOM PLATE FASTENING OR TRANSFER CLIPS PER SHEARWALL SCHEDULE TO CONNECT TOP/BOTTOM PLATES TO RIM JOIST/BLOCKING.


TYP SHEAR WALL TO JOIST CONNECTION FOR
EXTERIOR WALLS
N.T.S.

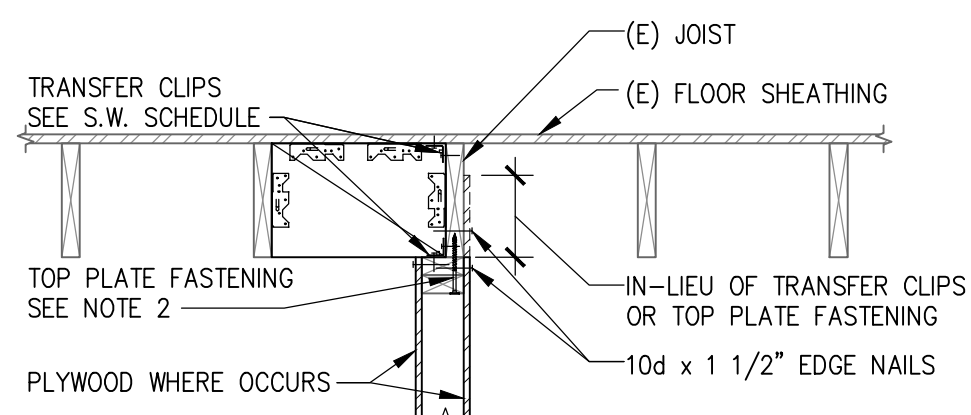

DIRECTLY UNDER JOIST


NOTES:

- 1) FASTEN A35 AND TRANSFER CLIPS TO FLOOR DIAPHRAGM ABOVE W/ #8 3/4" SCREWS AT UPPER LEG IF NOT DIRECTLY BELOW WALL. FASTEN A35 CLIPS
- 2) USE EITHER TOP/BOTTOM PLATE FASTENING OR TRANSFER CLIPS PER SHEARWALL SCHEDULE TO CONNECT TOP/BOTTOM PLATES TO RIM JOIST/BLOCKING.

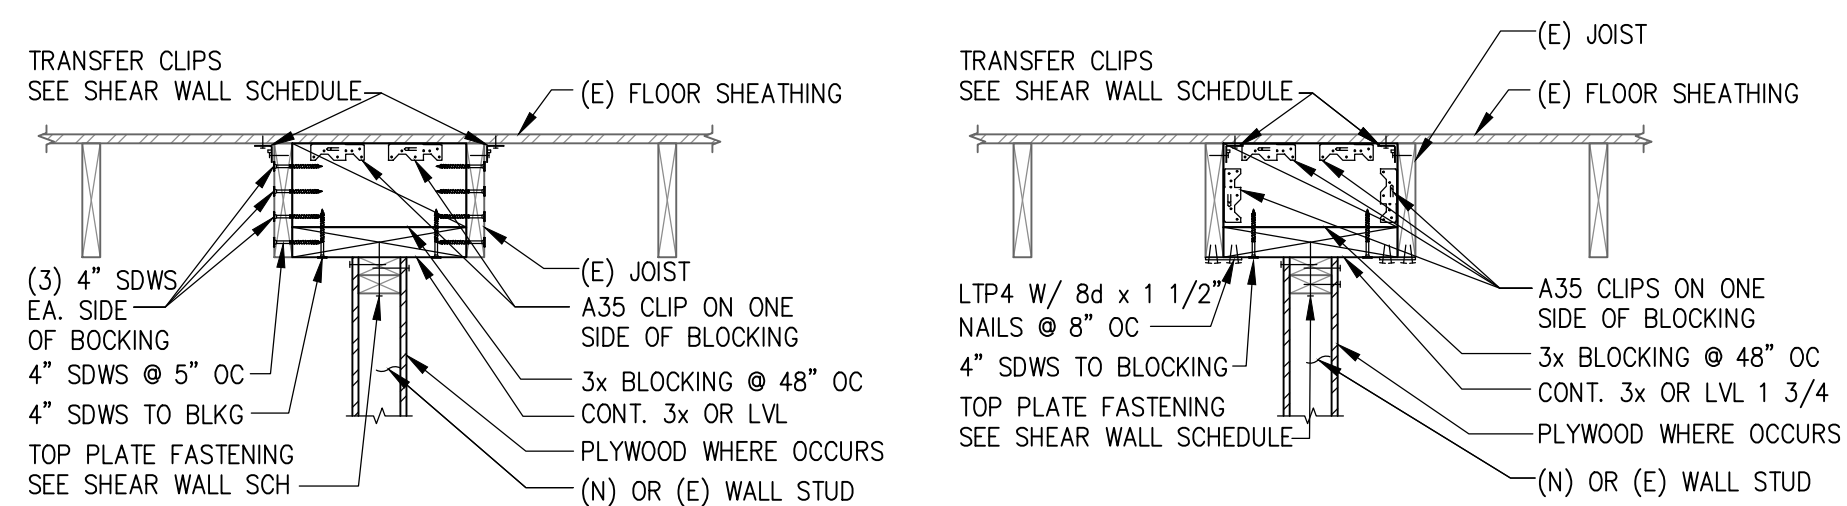

BETWEEN JOIST OPTION 1


TYP SHEAR WALL TO JOIST CONNECTION
FOR INTERIOR WALLS PARALLEL TO JOIST
N.T.S.

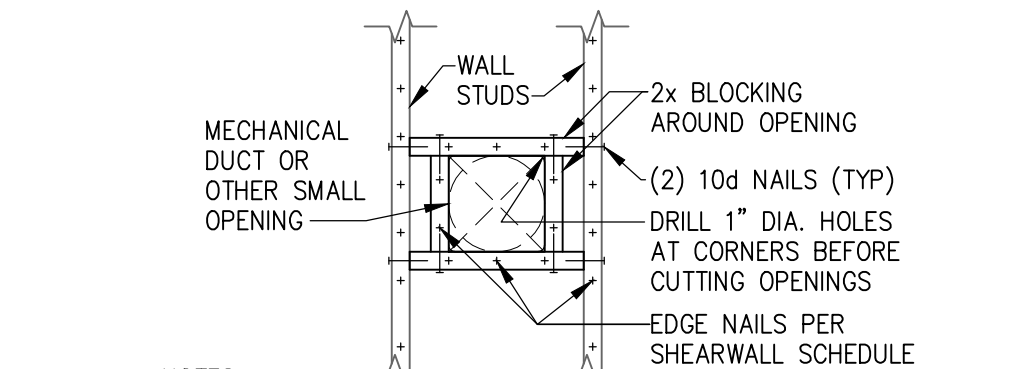

NOTES:

- 1) SHEARWALL PANELS NOT SHOWN FOR CLARITY.
- 2) NO OPENINGS OVER 12" IN LENGTH OR WIDTH TO OCCUR UNLESS APPROVED BY THE ENGINEER.
- 3) NO MORE THAN ONE OPENING ALLOWED WITHIN ONE SHEAR PANEL.


TYP SMALL OPENING IN SHEAR WALL
N.T.S.

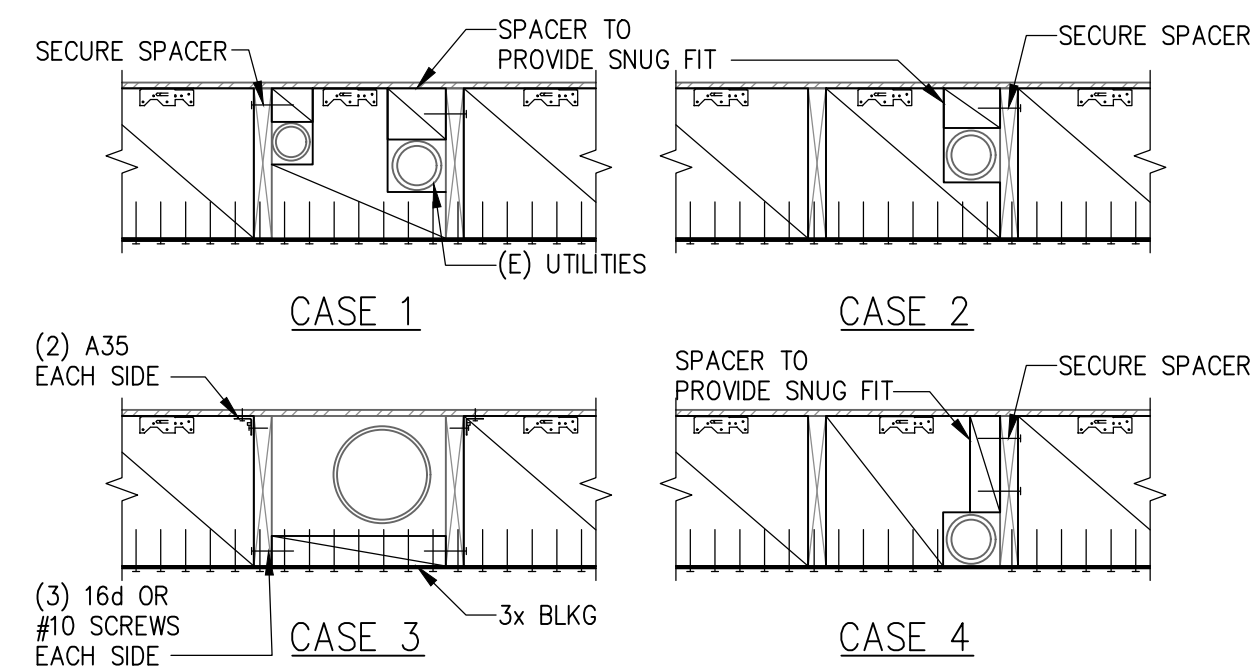

NOTES:


- 1) BLOCKING IN BAYS WITH UTILITY INTERFERENCE SHALL BE 3x MINIMUM.

TYP UTILITIY CONFLICTS AT STRAPPED BLOCKING	8
N.T.S.	-

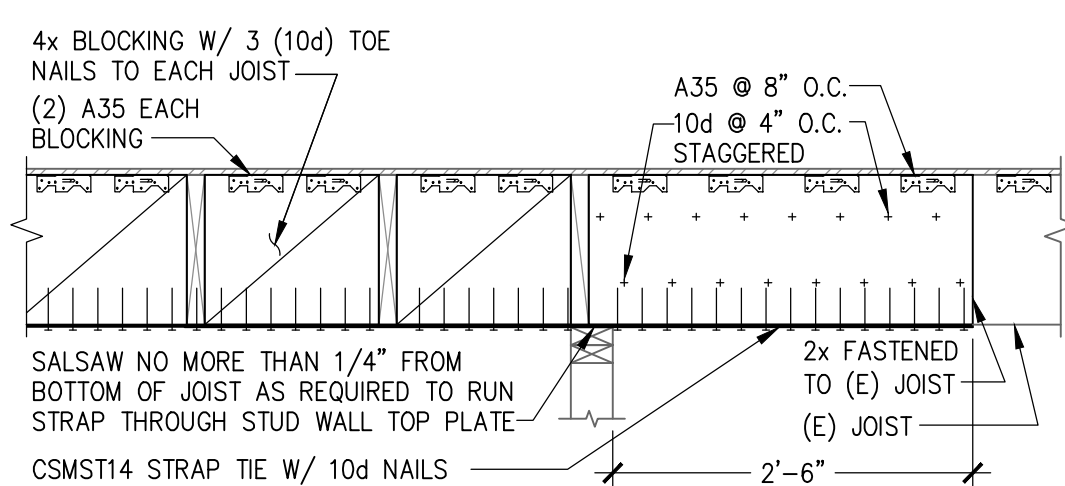

SCENARIO 2 – CHANGE IN JOIST DIRECTION

TYP STRAPPED BLOCKING	6
N.T.S.	-

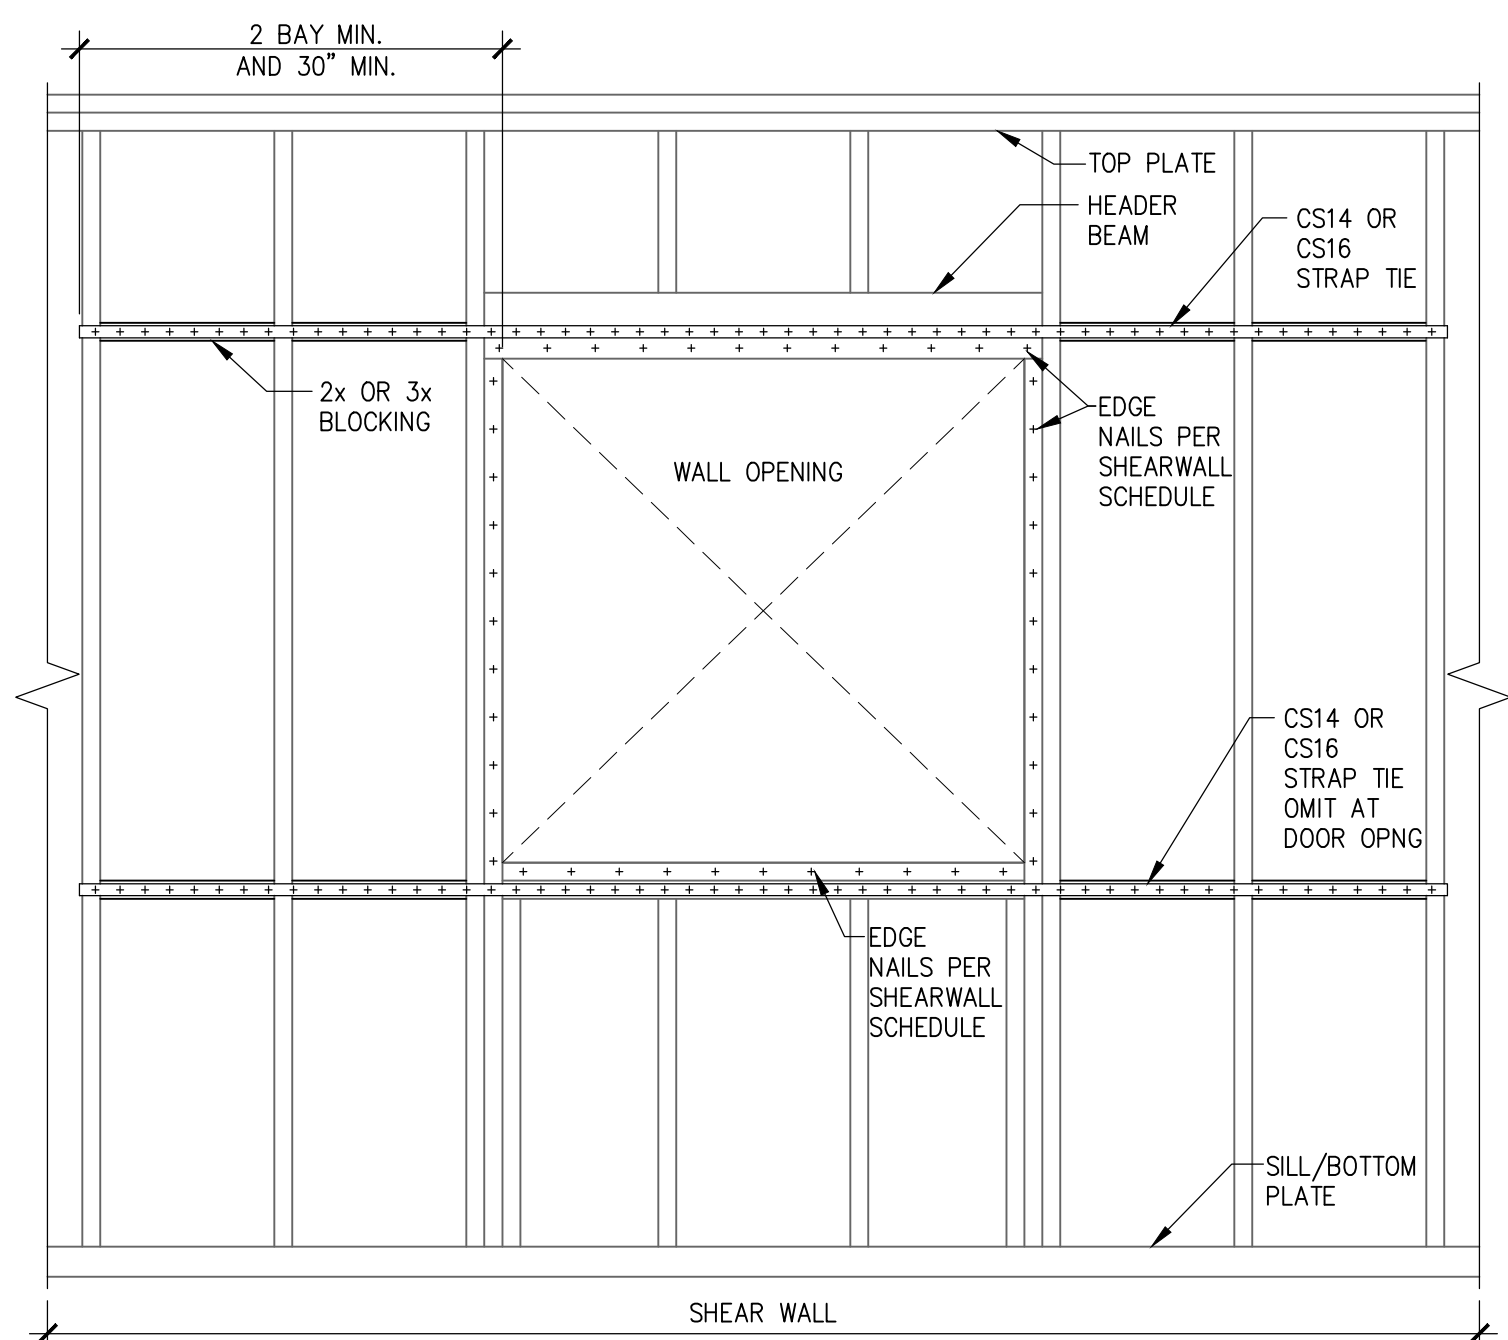


NOTE: SEE WALL FRAMING DETAIL AND SHEAR WALL DETAIL FOR INFORMATION NOT SHOWN

TYP OPENING IN SHEAR WALL DETAIL	9
N.T.S.	-




09/01/2021

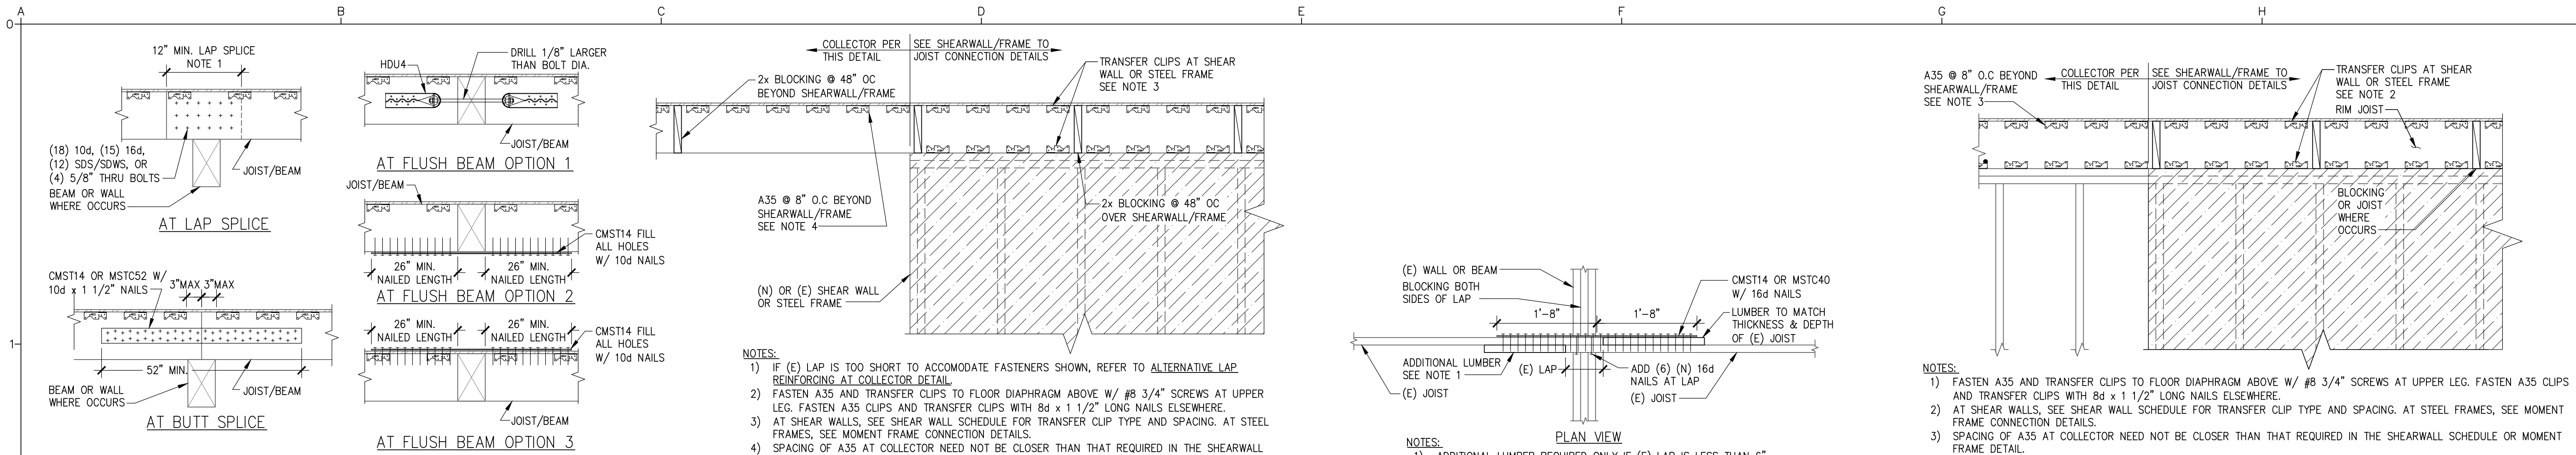

TYP COLLECTOR FOR INTERIOR WALLS/FRAMES PARALLEL TO JOIST


N.T.S.

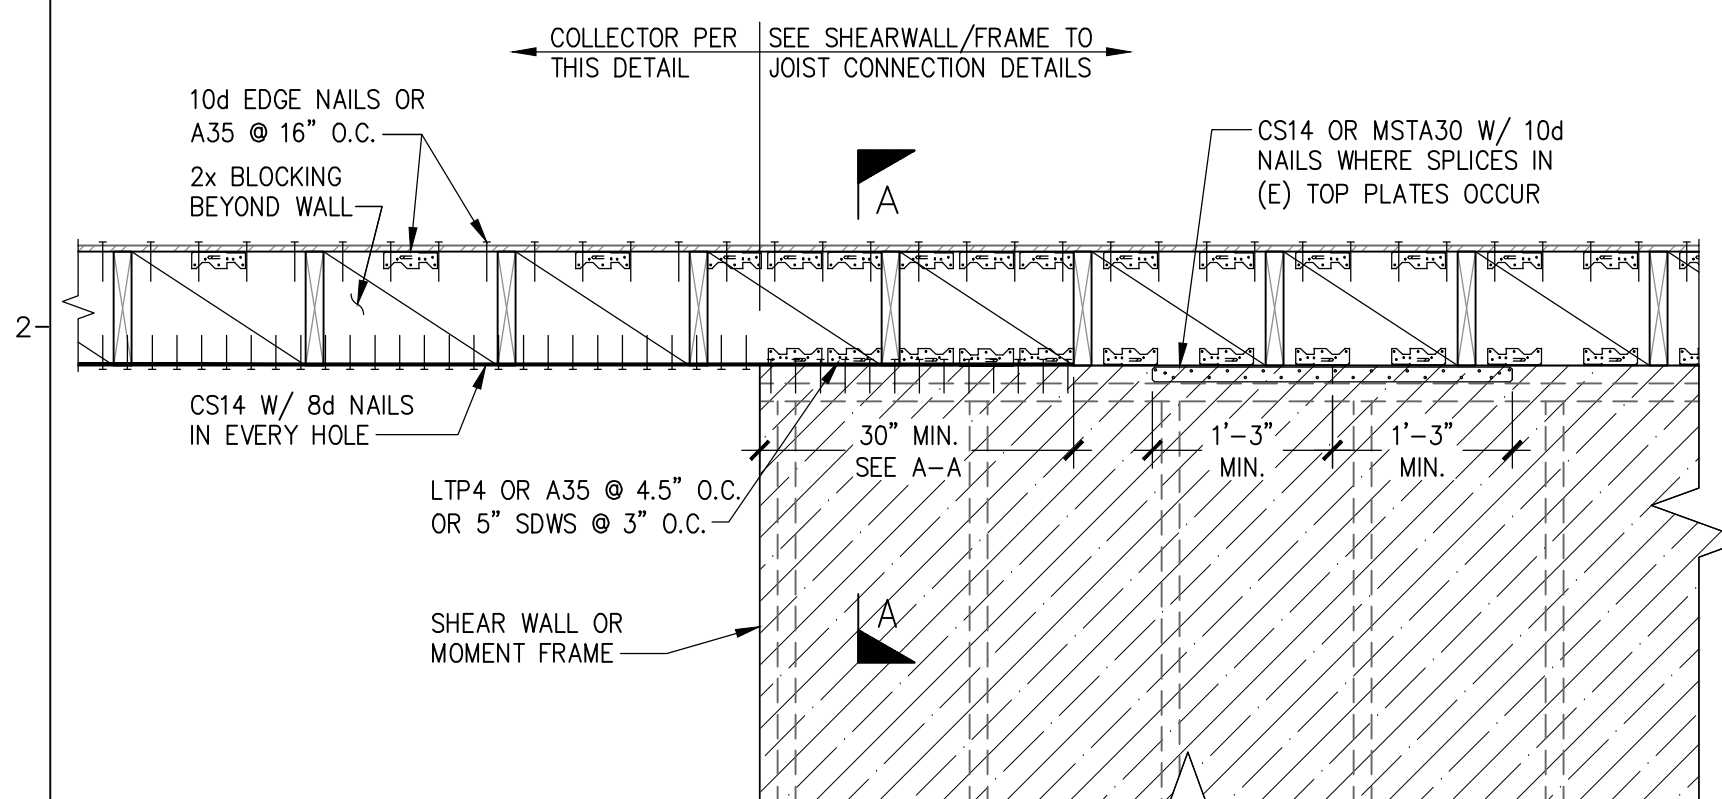

- NOTES:**
 1) FASTEN A35 AND TRANSFER CLIPS TO FLOOR DIAPHRAGM ABOVE W/ #8 3/4" SCREWS AT UPPER LEG IF NOT DIRECTLY BELOW WALL. FASTEN A35 CLIPS AND TRANSFER CLIPS WITH 8d x 1 1/2" LONG NAILS ELSEWHERE.

TYP COLLECTOR FOR INTERIOR WALLS/FRAMES PERPENDICULAR TO JOIST

N.T.S.


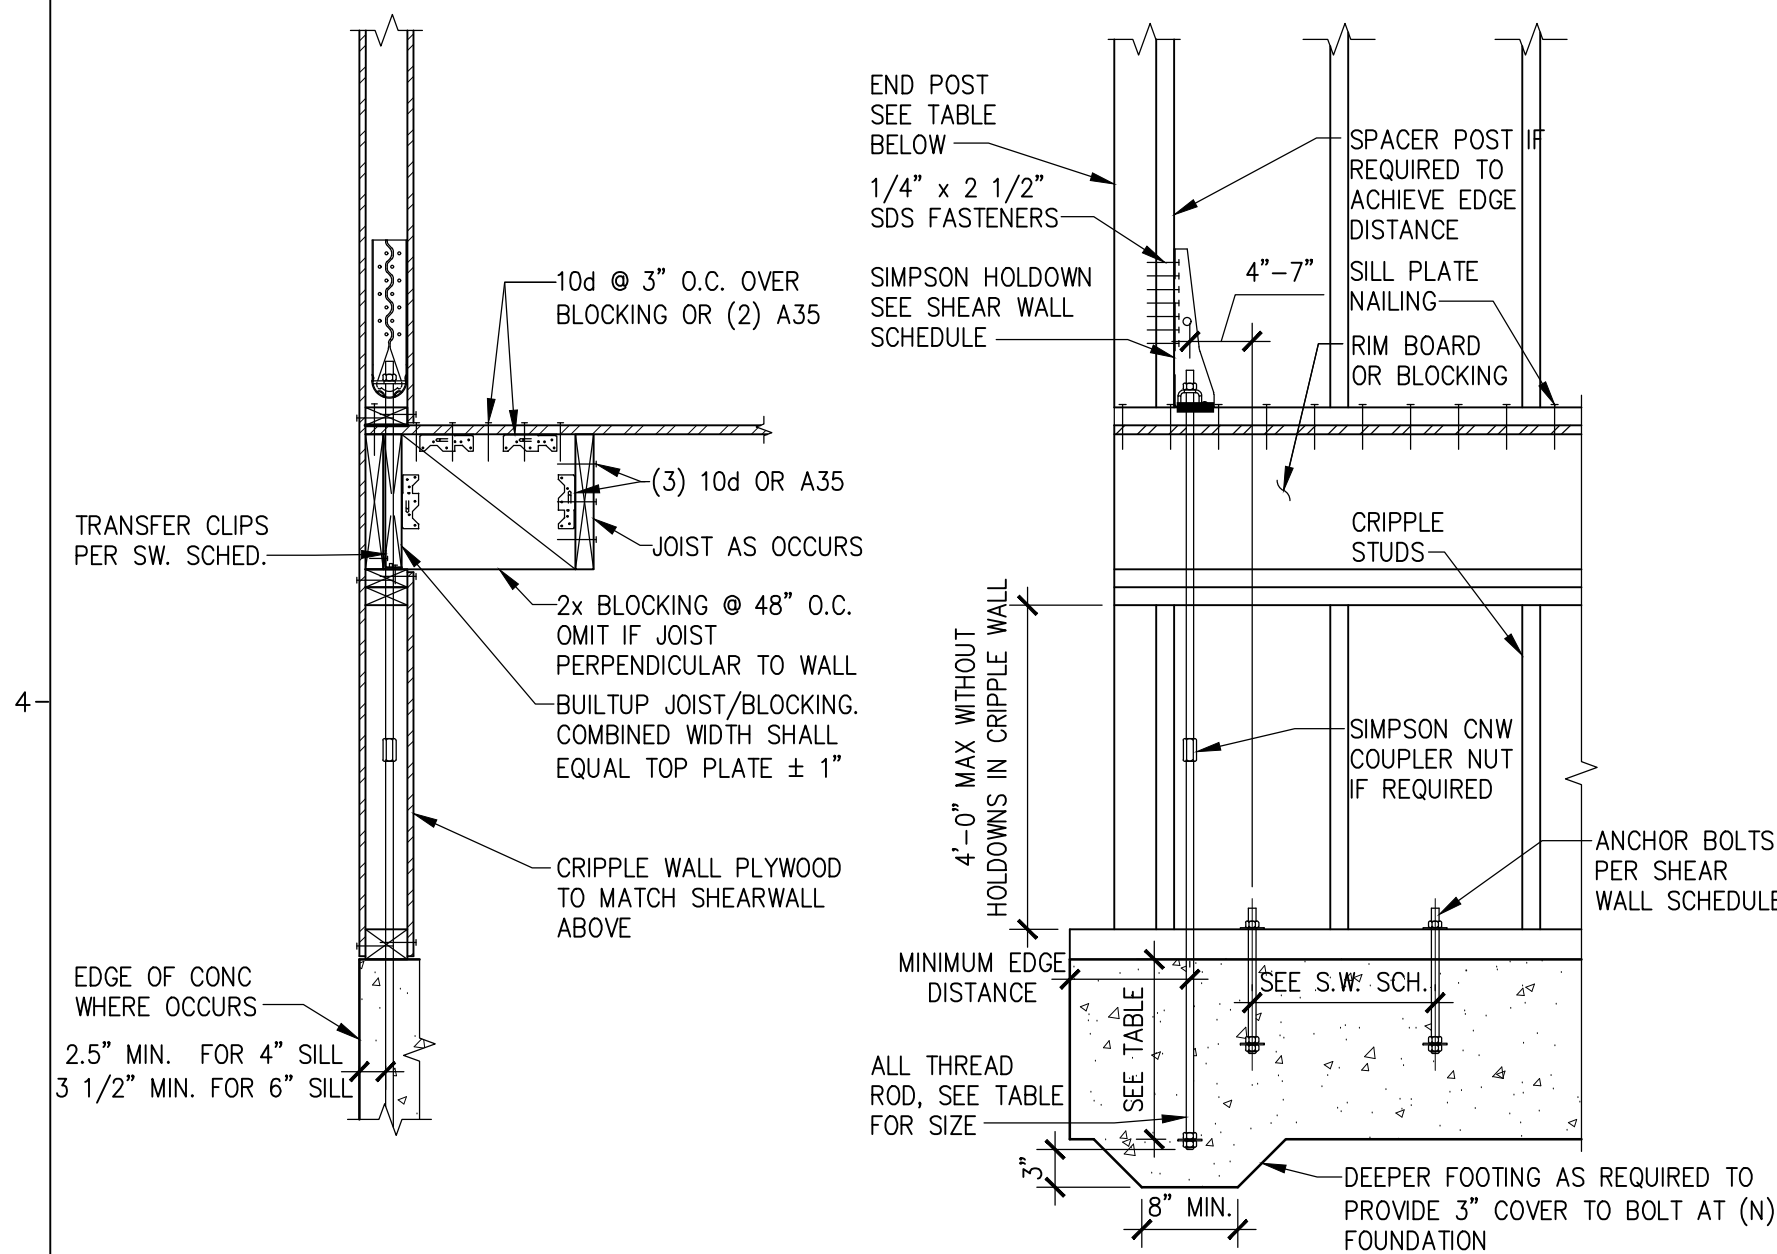


HOLDOWN	BOLT FOR (N) FOUNDATION	BOLT FOR (E) FOUNDATION	MINIMUM EMB. FOR (N) FDN	MINIMUM EMB. FOR (E) FDN ²	MINIMUM EDGE DISTANCE	MINIMUM POST SIZE ¹ FOR 4x STUD WALL	MINIMUM POST SIZE ¹ FOR 6x STUD WALL
HDU2	5/8" ROD OR PAB5-12HDG	5/8" ROD OR RFB#5x12HDG	7"	7"	4"	3"x3.5"	3"x5.5"
HDU4	5/8" ROD OR PAB5-18HDG	5/8" ROD OR RFB#5x16HDG	10"	10"	7"	3"x3.5"	3"x5.5"
HDU5	5/8" ROD OR PAB5-18HDG	5/8" ROD OR RFB#5x16HDG	12"	12"	8"	3"x3.5"	3"x5.5"
HDU8	7/8" ROD OR PAB7-24HDG	7/8" ROD HDG	15"	15"	10"	4.5"x3.5"	3.5"x5.5"
HDU11	1" ROD OR PAB8-30HDG	N/A	21"	N/A	10"	7.25"x3.5"	4.5"x5.5"
HDU14	1" ROD OR PAB8-30HDG	N/A	21"	N/A	10"	7.25"x3.5"	5.5"x5.5"

- ¹ FOR BUILT-UP END POST, EDGE NAILS PER SHEAR WALL SCHEDULE SHALL BE APPLIED ON EACH MEMBER OF THE BUILT-UP POST.
² EMBEDMENT DEPTH IS MEASURED STARTING FROM THE FULL CONCRETE FOOTING WIDTH. THE LENGTH OF ROD THROUGH CONCRETE STEM WALLS DOES NOT COUNT AS EMBEDMENT.

ALTERNATIVE LAP REINFORCING AT COLLECTOR


N.T.S.

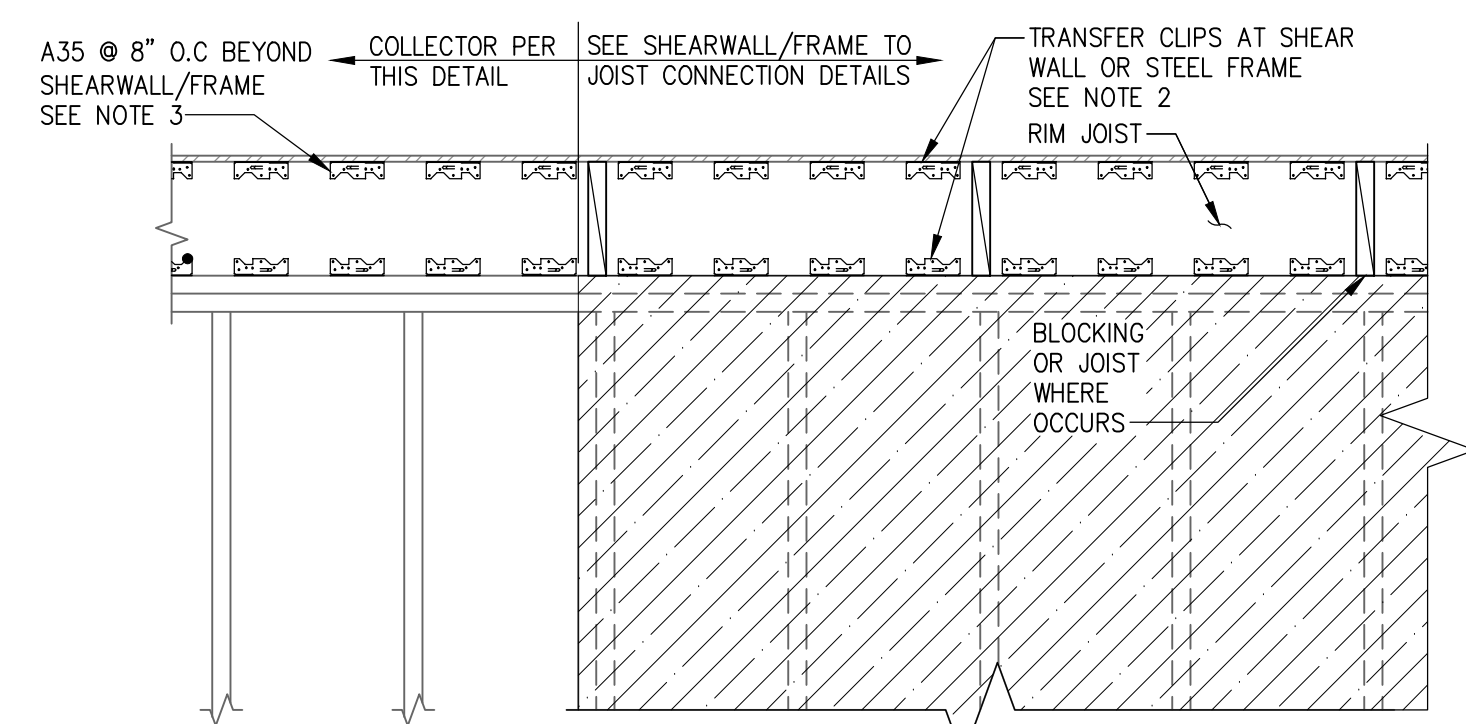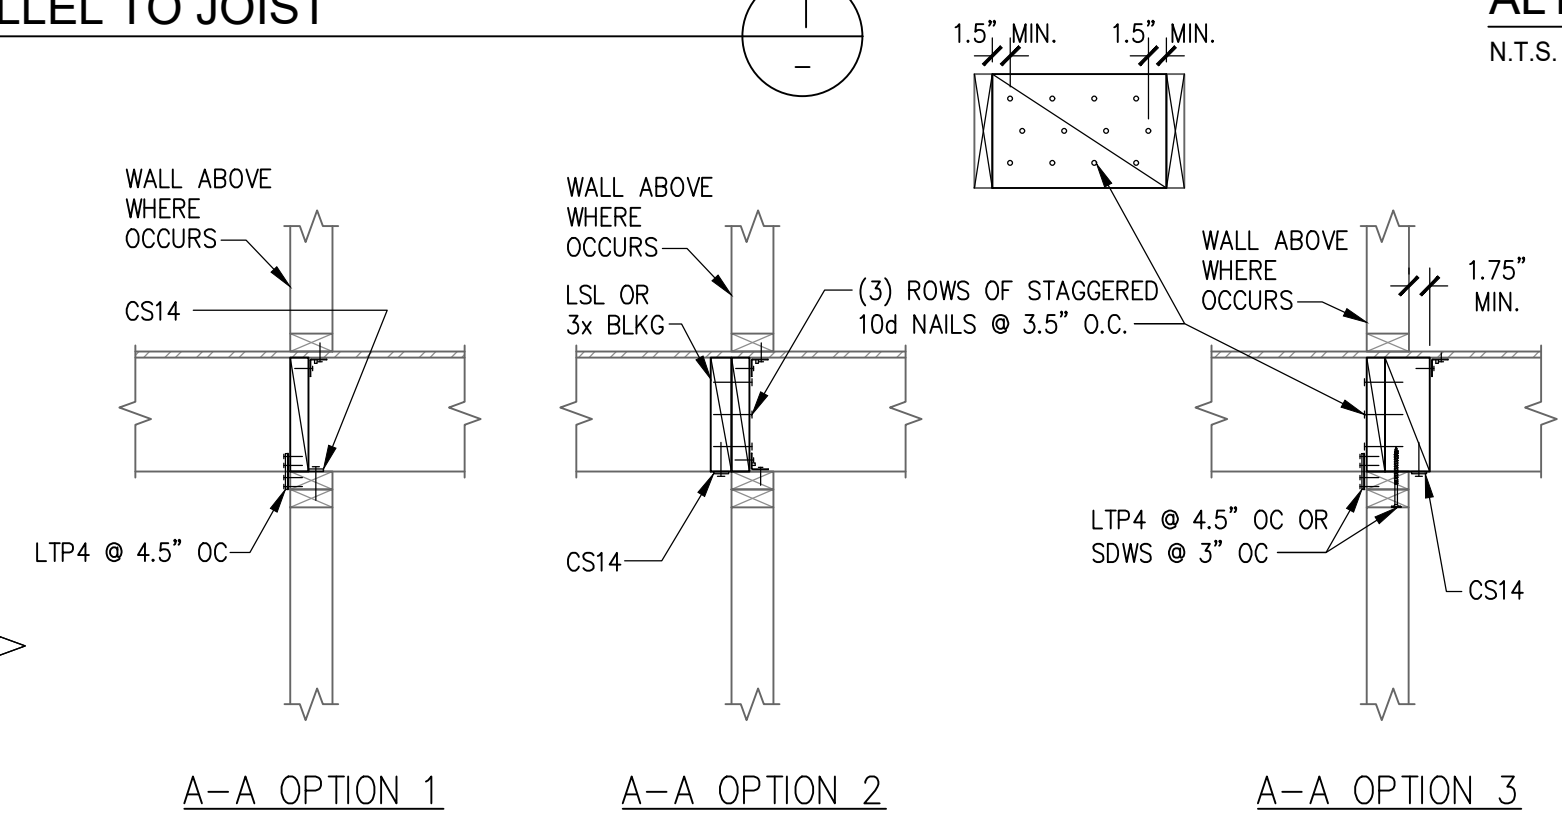

- NOTES:**
 1) FASTEN A35 AND TRANSFER CLIPS TO FLOOR DIAPHRAGM ABOVE W/ #8 3/4" SCREWS AT UPPER LEG. FASTEN A35 CLIPS AND TRANSFER CLIPS WITH 8d x 1 1/2" LONG NAILS ELSEWHERE.
 2) AT SHEAR WALLS, SEE SHEAR WALL SCHEDULE FOR TRANSFER CLIP TYPE AND SPACING. AT STEEL FRAMES, SEE MOMENT FRAME CONNECTION DETAILS.
 3) SPACING OF A35 AT COLLECTOR NEED NOT BE CLOSER THAN THAT REQUIRED IN THE SHEARWALL SCHEDULE OR MOMENT FRAME DETAIL.

TYP COLLECTOR FOR EXTERIOR SHEAR WALLS

N.T.S.

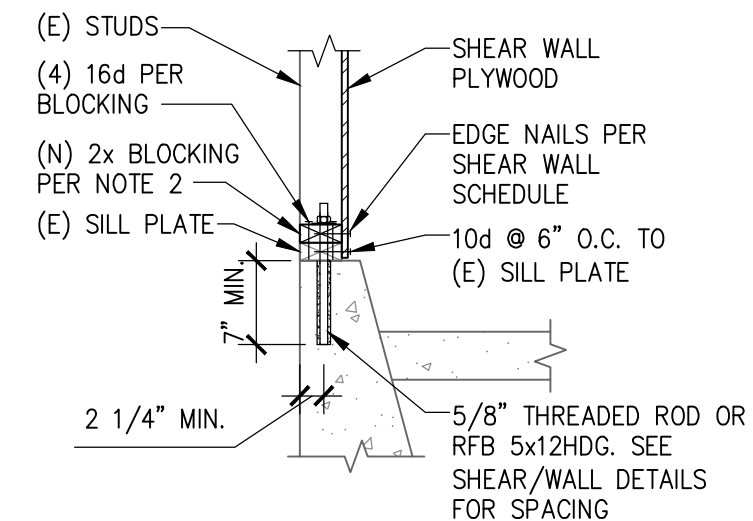

- NOTES:**
 1) EPOXY SHALL BE SIMPSON SET-XP OR HILTI HIT-RE 500-SD. INSTALL PER MANUFACTURER'S INSTRUCTIONS.
 2) PROVE 2x BLOCKING BETWEEN WALL STUDS WHEN EITHER:
 A) (E) SILL PLATE IS LESS THAN 3x THICK.
 B) (E) SILL PLATE IS WIDER THAN (E) WALL STUDS.

TYP (N) ANCHOR BOLTS TO (E) FOOTING

N.T.S.

TYPICAL STRUCTURAL DETAILS
LEGALIZE GROUND FLOOR ADDITION
338 TEDDY AVE,
SAN FRANCISCO, CA 94134

DRAWN:

CHECKED:

DATE: SEPTEMBER 2021

SCALE: AS NOTED

SHEET/FILE:

S1.3

OF / SHEETS

Engineer: Doug Lee, P.E., LEED® AP
 Phone: 415-254-8920
 Email: DLee8995@gmail.com

1

2


3








09/01/2021

NOTE: THIS DRAWING IS COPYRIGHT. CONTRACTORS MUST CHECK ALL DIMENSIONS ON SITE. ONLY FIGURED DIMENSIONS ARE TO BE WORKED FROM. ANY DISCREPANCIES ARE TO BE REPORTED TO THE ENGINEER AND OWNER BEFORE PROCEEDING.



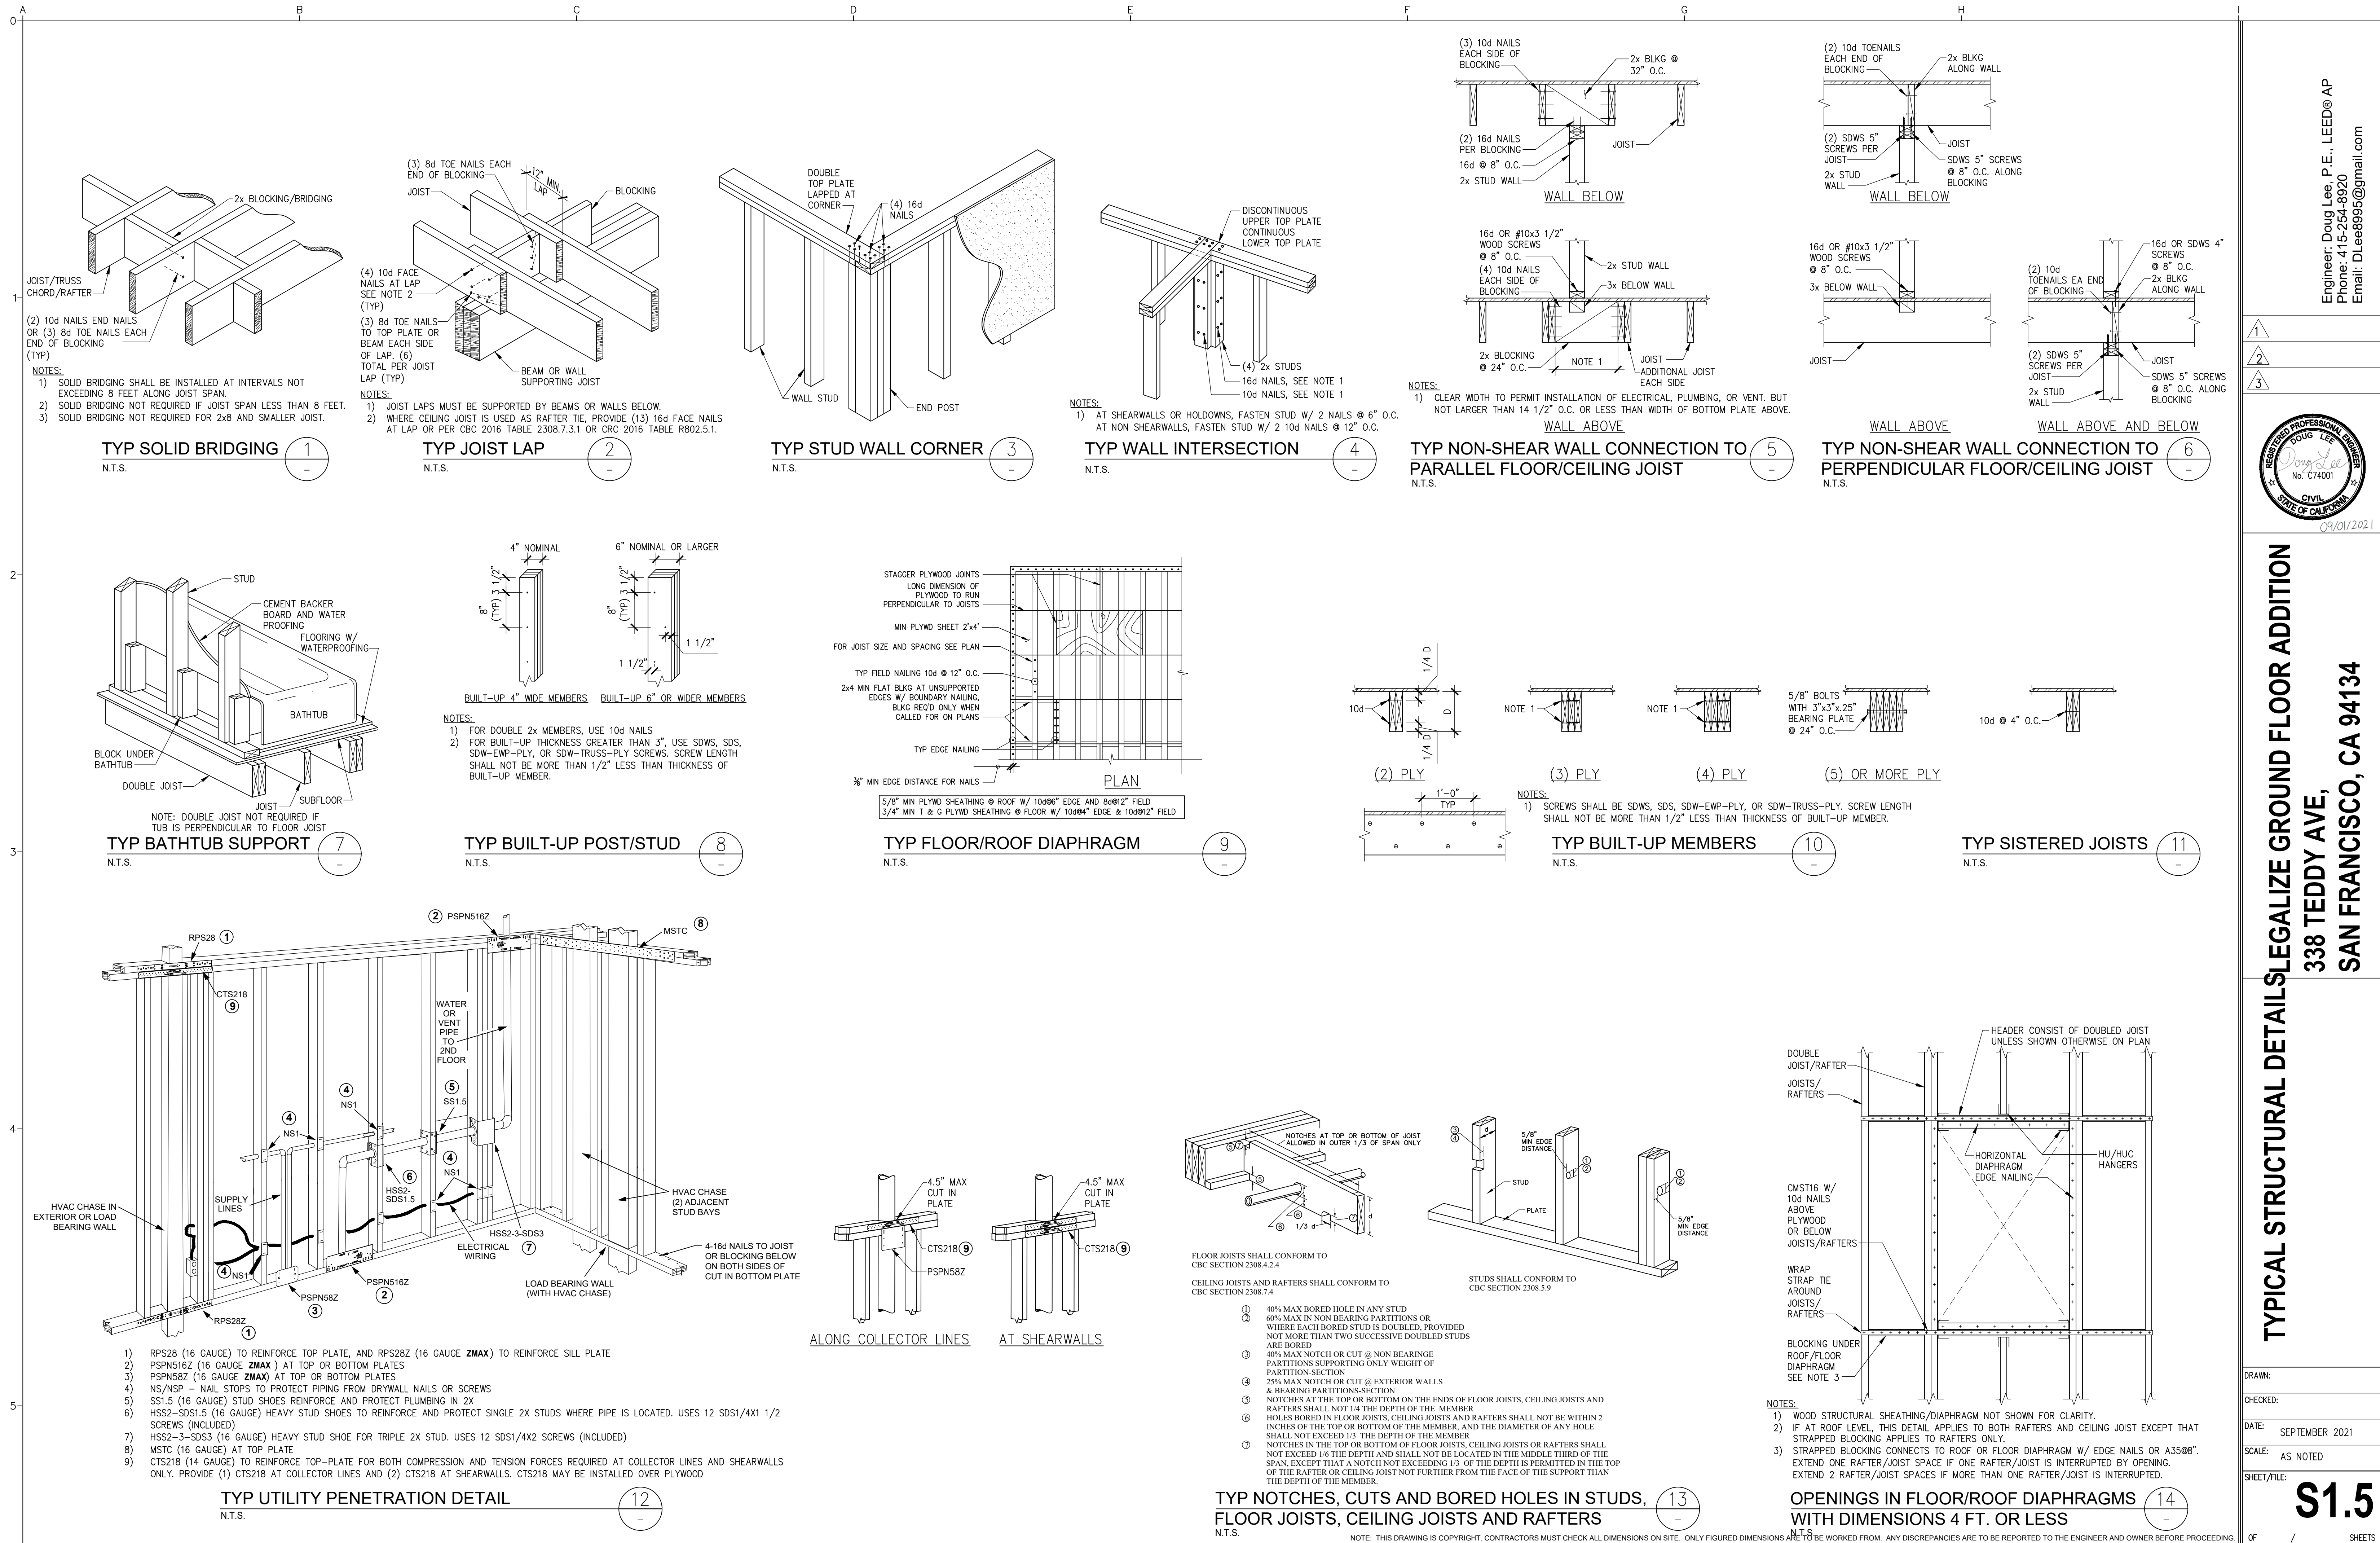

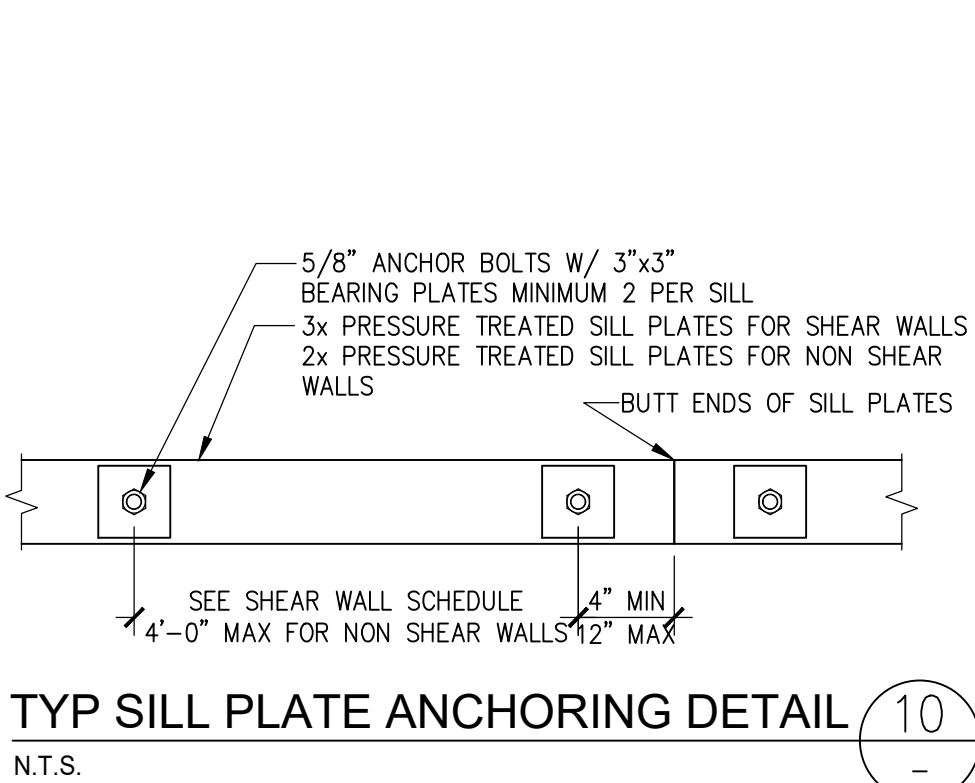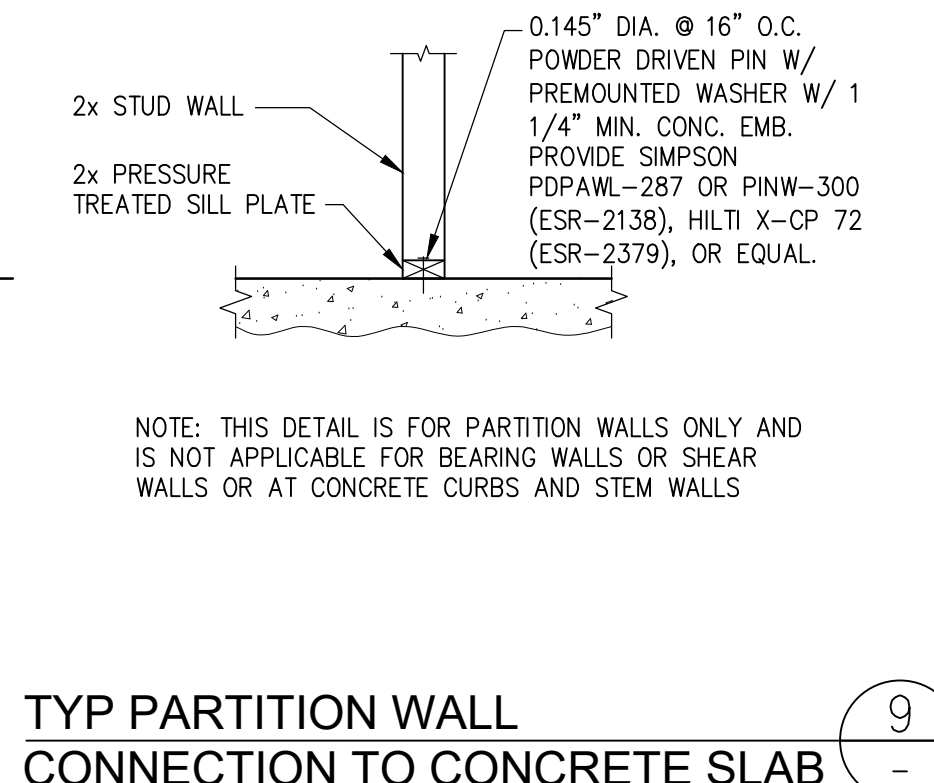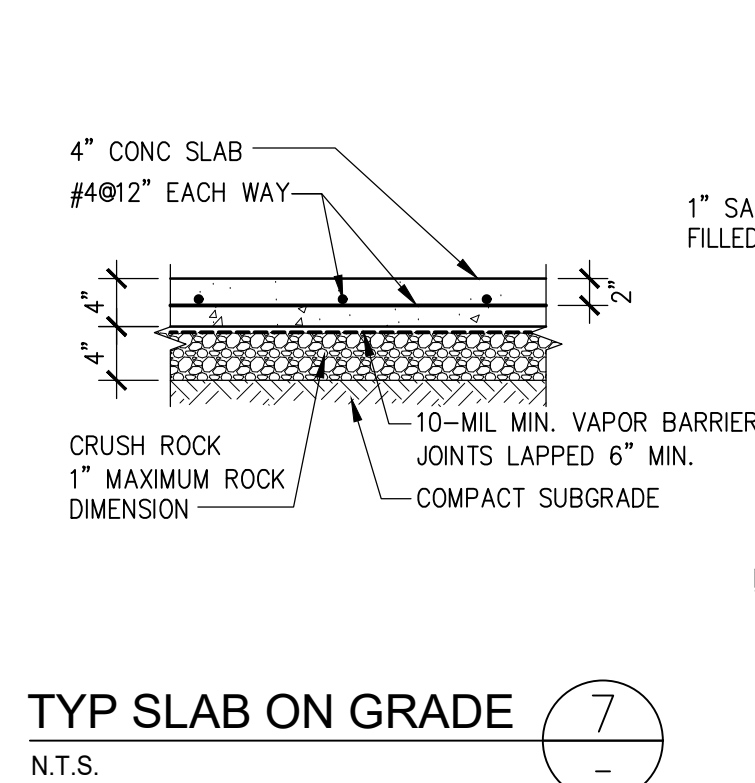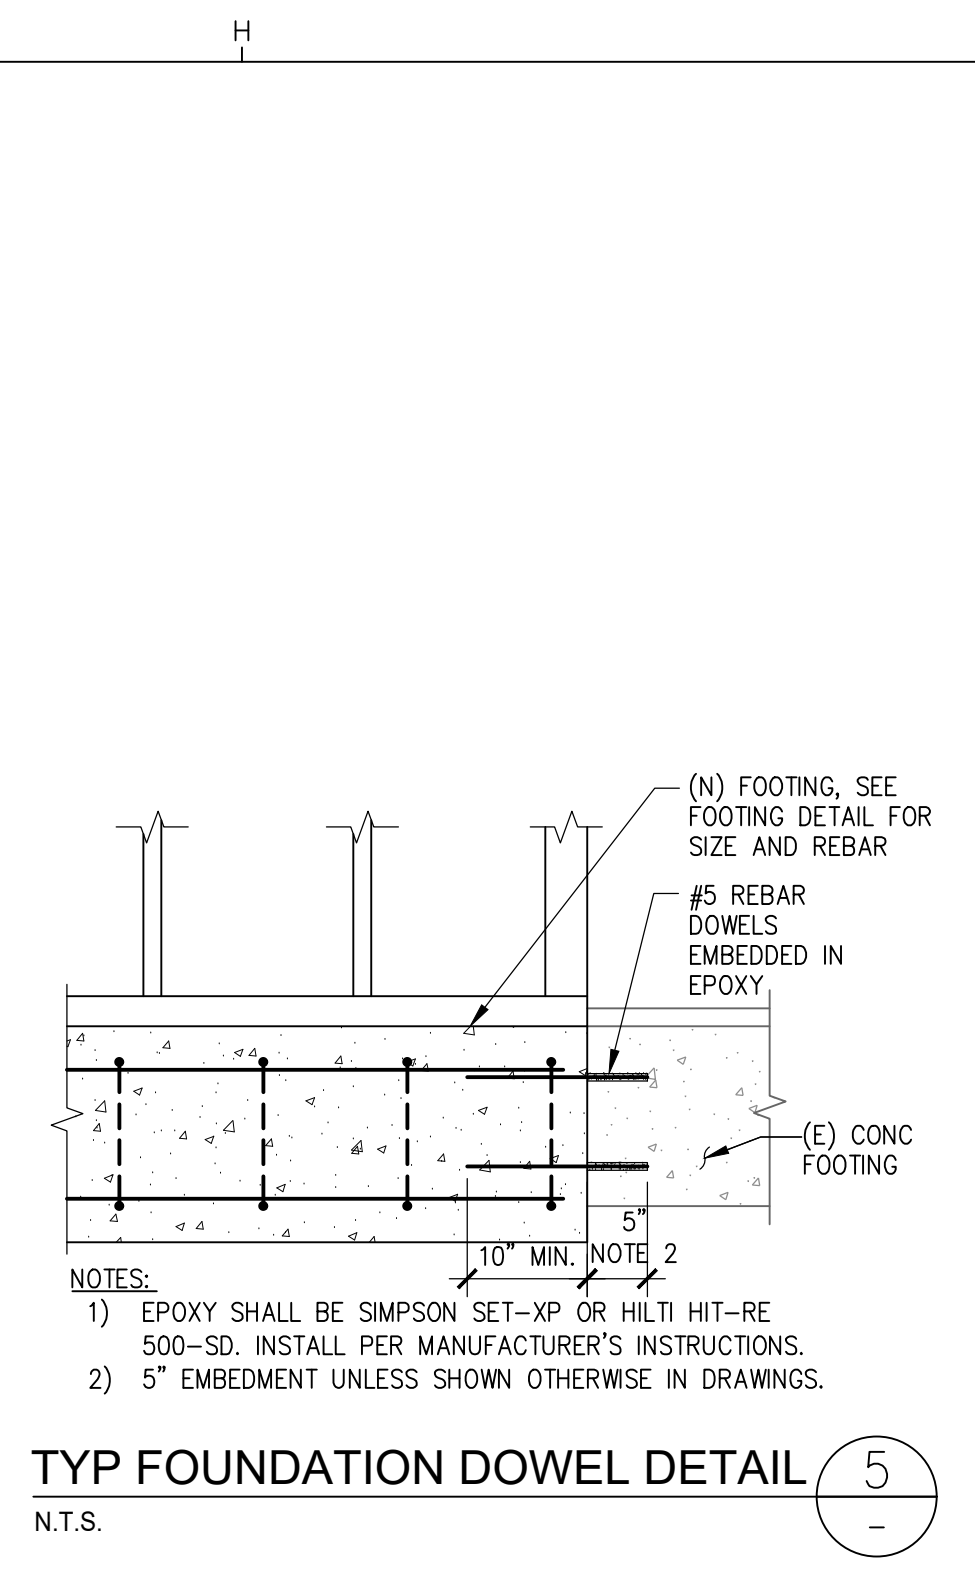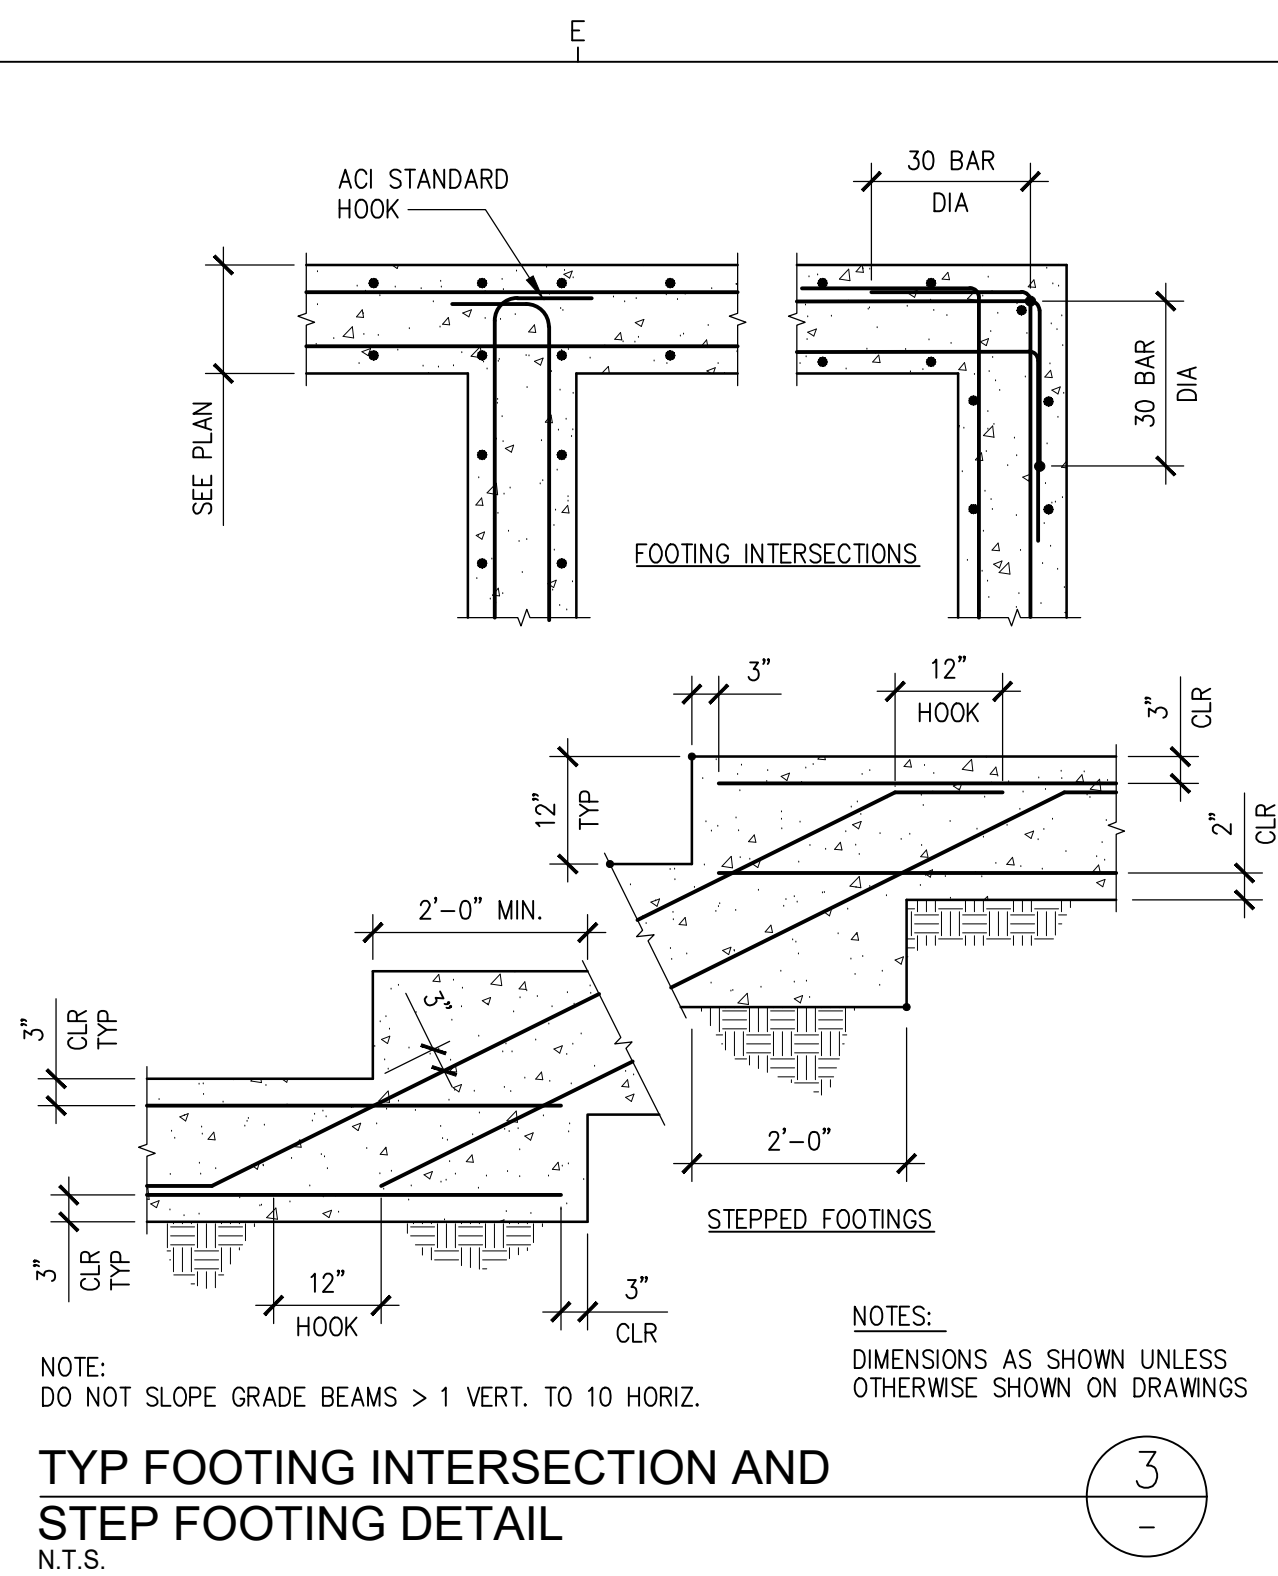

Engineer: Doug Lee, P.E., LEED® AP
Phone: 415-254-8920
Email: DLee8995@gmail.com




09/01/202

TYPICAL STRUCTURAL DETAILS LEGALIZE GROUND FLOOR ADDITION
338 TEDDY AVE,
SAN FRANCISCO, CA 94134


DRAWN:	
CHECKED:	
DATE:	SEPTEMBER 2021
SCALE:	AS NOTED
SHEET/FILE:	

S1.6


NOTE: THIS DRAWING IS COPYRIGHT. CONTRACTORS MUST CHECK ALL DIMENSIONS ON SITE. ONLY FIGURED DIMENSIONS ARE TO BE WORKED FROM. ANY DISCREPANCIES ARE TO BE REPORTED TO THE ENGINEER AND OWNER BEFORE PROCEEDING.

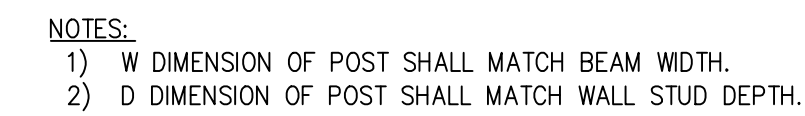

WALL SUPPORT FOR DROP BEAM
N.T.S.

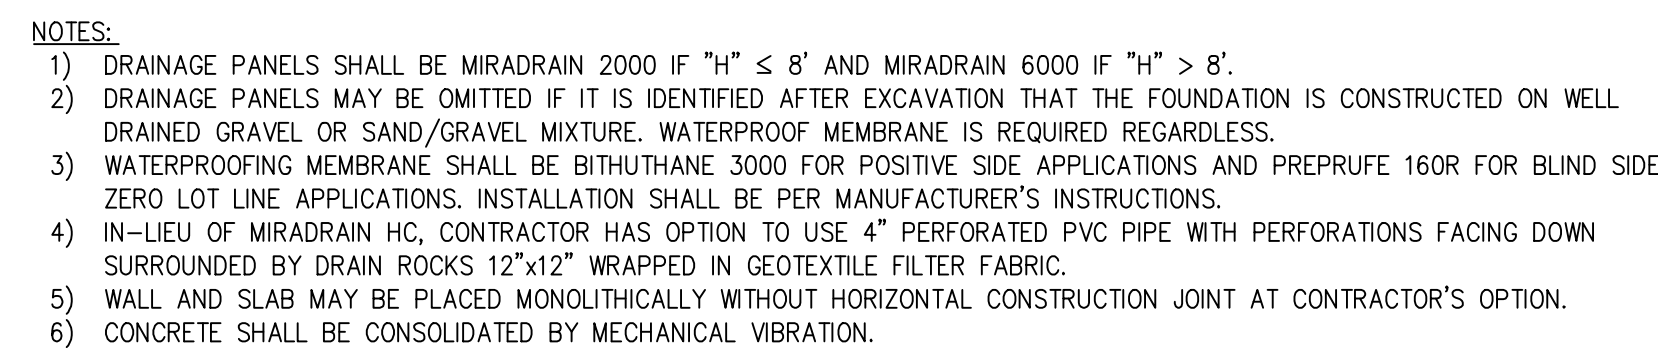


TYP RETAINING WALL FOUNDATION

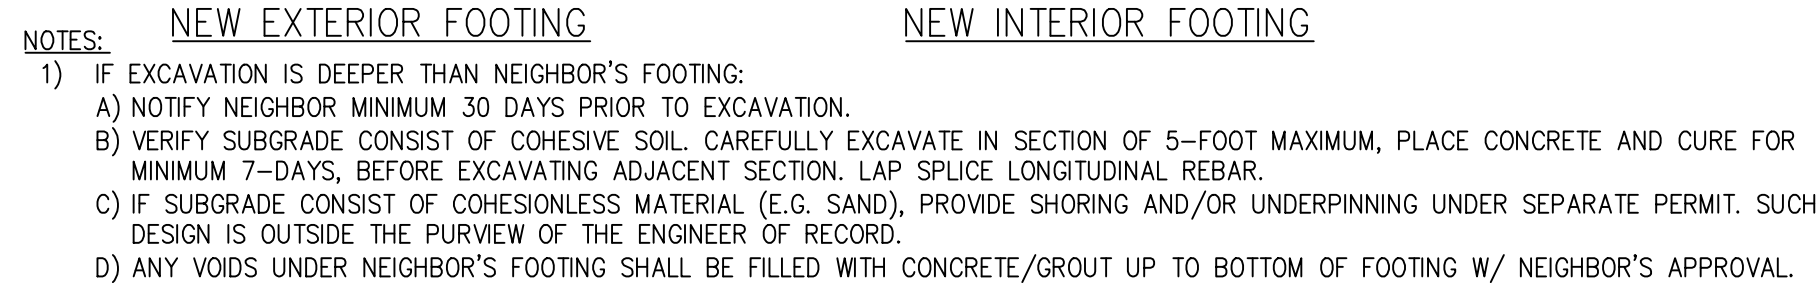

TYP FOOTING

N.T.S.

4
-

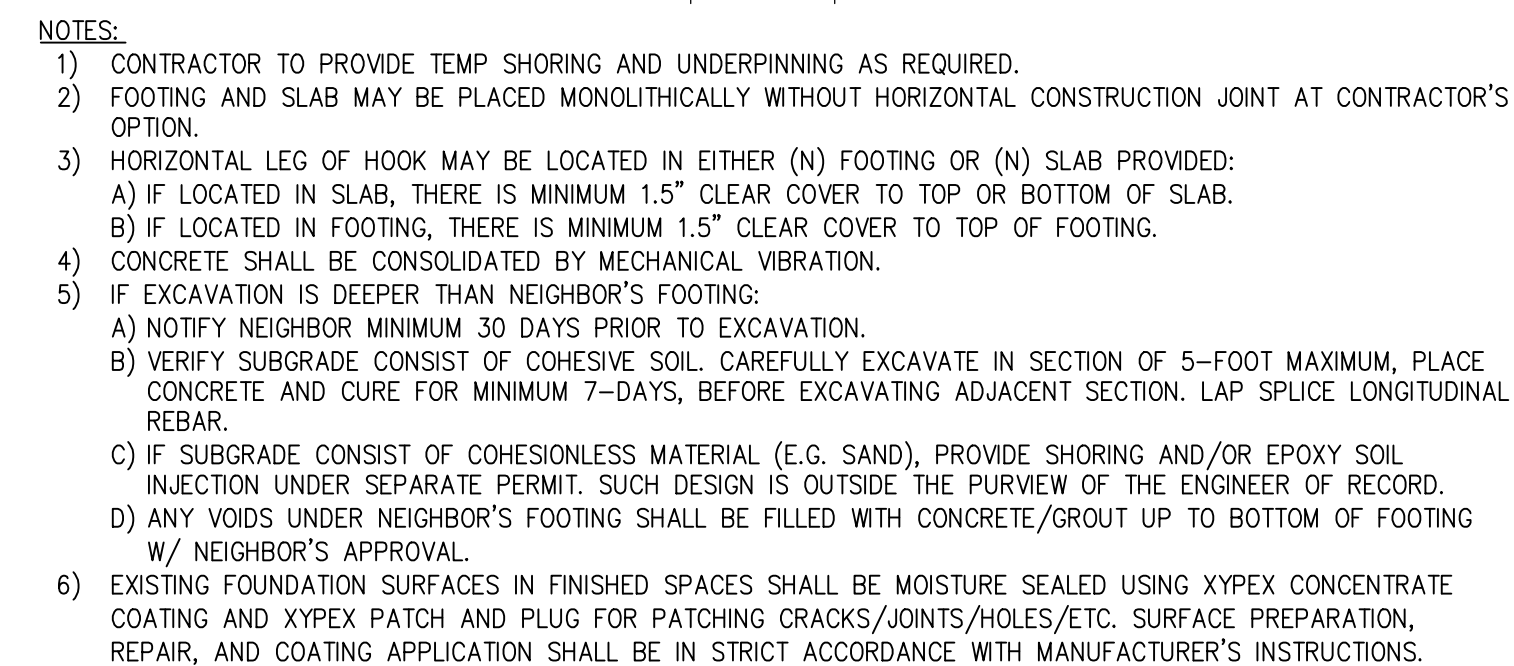

TYP (E) FOOTING EXTENSION AS REQUIRED FOR LOWERED SLAB

N.T.S.

4A
-



**LEGALIZE GROUND FLOOR ADDITION
338 TEDDY AVE,
SAN FRANCISCO, CA 94134**

STRUCTURAL DETAILS

DRAWN:

CHECKED:

DATE: SEPTEMBER 2021

SCALE: AS NOTED

SHEET/FILE:

S3

Complainant's
Phone:
Complaint Source: WEB FORM
Assigned to
Division: CES
Description: date last observed: 31-MAY-21; Identity of person performing the work: I wish to remain anonymous; exact location: In-Law Unit; building type: Residence/Dwelling ILLEGAL UNIT; WORK W/O PERMIT; ILLEGAL CHANGE OF USE; OTHER PLUMBING ; additional information: Illega kitchen in downstairs unit w/o permit;
Instructions:

Ralling:
Occupancy Code:
Received By: WSTROM
Division: BID

E2

INSPECTOR CURRENTLY ASSIGNED						
DIVISION	INSPECTOR			ID	DISTRICT	PRIORITY
CES	MCCONN			6960		
REFERRAL INFORMATION						
DATE	REFERRED BY	TO	COMMENT			
12/9/2022	Suzanna Wong	CES	Per Jimmy Gualumi			
COMPLAINT STATUS AND COMMENTS						
DATE	TYPE	INSPECTOR	STATUS	COMMENT	UPDATED BY	DIV
07/07/21	CASE OPENED	Walsh	CASE RECEIVED		William Strom 07-JUL-21	IPR
07/07/21	OTHER BLDG/ HOUSING VIOLATION	Gualumi	CASE UPDATE	Case reviewed and assigned to complaint investigation team per MH; WS	William Strom 07-JUL-21	IPR
07/09/21	OTHER BLDG/ HOUSING VIOLATION	Gualumi	CASE UPDATE	Met with electrical contractor. Site inspection revealed a bathroom, wet bar and 3 Storage rooms at ground Floor. Permit research Required. Jg		BID
07/12/21	OTHER BLDG/ HOUSING VIOLATION	Gualumi	CASE UPDATE	Posted nov. Jg		BID
07/12/21	OTHER BLDG/ HOUSING VIOLATION	Gualumi	FIRST NOV SENT	1st NOV Issued per JG; ag	Audrey Gee 13-JUL-21	INS
07/13/21	OTHER BLDG/ HOUSING VIOLATION	Gualumi	CASE UPDATE	1st NOV mailed; ag	Audrey Gee 13-JUL-21	INS
08/12/21	OTHER BLDG/ HOUSING VIOLATION	Gualumi	CASE UPDATE	PA 202108116263 filed to comply with NOV. JG		BID
10/12/21	OTHER BLDG/ HOUSING VIOLATION	Gualumi	CASE UPDATE	permit filed to comply with NOV. JG		BID
12/22/21	OTHER BLDG/ HOUSING VIOLATION	Gualumi	CASE UPDATE	permit to comply with NOV filed on 8-11-21. JG		BID
12/08/22	OTHER BLDG/ HOUSING VIOLATION	Gualumi	FINAL WARNING LETTER ISSUED	no movement on filed permit since October of 2021. JG		BID
12/08/22	OTHER BLDG/ HOUSING VIOLATION	Gualumi	FINAL WARNING LETTER SENT	refer to CES. JG	Jimmy Gualumi 08-DEC-22	BID
12/09/22	GENERAL MAINTENANCE	Gualumi	REFERRED TO OTHER DIV	transfer to div CES	Suzanna Wong 09-DEC-22	BID
12/09/22	OTHER BLDG/ HOUSING VIOLATION	Gualumi	CASE UPDATE	Final warning letter mailed; slw	Suzanna Wong 09-DEC-22	BID
12/09/22	OTHER BLDG/ HOUSING VIOLATION	Gualumi	REFERRED TO OTHER DIV	Case referred to CES per JG; slw	Suzanna Wong 09-DEC-22	BID
12/09/22	GENERAL MAINTENANCE	Hinchion	CASE RECEIVED	Received case in CES. SB	Sonya Bryant 09-DEC-22	CES
08/19/24	GENERAL MAINTENANCE	McConn	CASE UPDATE	research permit history / status PA 202108116263 filed but not issued - DMC	Declan McConn 19-AUG-24	CES
08/19/24	GENERAL MAINTENANCE	McConn	CASE UPDATE	case update / ok to send to DH on 9/3/24 - DMC	Declan McConn 19-AUG-24	CES
08/20/24	OTHER BLDG/ HOUSING VIOLATION	McConn	CASE UPDATE	Prepared DH packet. SB	Sonya Bryant 20-AUG-24	CES
08/21/24	GENERAL MAINTENANCE	McConn	CASE UPDATE	went out to sit to post DH notice and take pictures - DMC	Declan McConn 21-AUG-24	CES
08/21/24	GENERAL MAINTENANCE	McConn	CASE UPDATE	Sign affidavit and upload photos - DMC	Declan McConn 21-AUG-24	CES
08/21/24	GENERAL MAINTENANCE	McConn	CASE UPDATE	Update all DH files for HIF - DMC	Declan McConn 21-AUG-24	CES
08/22/24	GENERAL MAINTENANCE	McConn	CASE UPDATE	Updated case for HIF -DMC	Declan McConn 22-AUG-24	CES
08/22/24	OTHER BLDG/ HOUSING VIOLATION	McConn	CASE UPDATE	Cert Mailed DH packet to owners on file. SB	Sonya Bryant 22-AUG-24	CES
09/03/24	OTHER BLDG/ HOUSING VIOLATION	Ng	DIRECTOR'S HEARING DECISION	P/ 90-day advisement per H.O. (S. Panelli). JN	Joe Ng 03-SEP-24	CES
11/04/24	OTHER BLDG/ HOUSING VIOLATION	McConn	CASE UPDATE	research permit history / status PA 202108116263 filed on 8/11/2021 but not issued - DMC	Declan McConn 04-NOV-24	CES
11/04/24	OTHER BLDG/ HOUSING VIOLATION	McConn	CASE UPDATE	research permit history / status PA 202108116263 filed on 8/11/2021 but not issued - DMC	Declan McConn 04-NOV-24	CES
12/10/24	OTHER BLDG/ HOUSING VIOLATION	McConn	CASE UPDATE	research permit history / status PA 202108116263 filed on 8/11/2021 but not issued - DMC	Declan McConn 10-DEC-24	CES
12/10/24	OTHER BLDG/ HOUSING VIOLATION	McConn	CASE UPDATE	case update / MMF from 12/9/22 to 12/10/24 (24 months) - DMC	Susan Jew 12-DEC-24	CES
12/10/24	OTHER BLDG/ HOUSING VIOLATION	McConn	CASE UPDATE	case update / Prepared Assessment of Costs - DMC	Declan McConn 10-DEC-24	CES
12/11/24	OTHER BLDG/ HOUSING VIOLATION	McConn	CASE UPDATE	Prepared OOA posting packet - sj	Susan Jew 11-DEC-24	CES
12/13/24	OTHER BLDG/ HOUSING VIOLATION	McConn	CASE UPDATE	case update / went out to site to post OOA and take pictures - DMC	Declan McConn 13-DEC-24	CES
12/13/24	OTHER BLDG/ HOUSING VIOLATION	McConn	CASE UPDATE	case update / sign affidavit - DMC	Declan McConn 13-DEC-24	CES
12/13/24	NONCONFORM USE VIOL	McConn	CASE UPDATE	case update / uploaded photos to file - DMC	Declan McConn 13-DEC-24	CES
12/13/24	OTHER BLDG/ HOUSING VIOLATION	McConn	CASE UPDATE	Cert Mailed OOA packet to owners on file - sj	Susan Jew 13-DEC-24	CES
12/23/24	OTHER BLDG/ HOUSING VIOLATION	McConn	CASE UPDATE	Processed IB payment and handed owner receipt-hb	Heather Brooks 23-DEC-24	CES
12/27/24	OTHER BLDG/ HOUSING VIOLATION	McConn	CASE UPDATE	Customer came in to pay fee for AAB. SB	Sonya Bryant 27-DEC-24	CES
12/27/24	OTHER BLDG/ HOUSING VIOLATION	McConn	CASE UPDATE	Processed AAB payment. SB	Sonya Bryant 27-DEC-24	CES
03/14/25	OTHER BLDG/ HOUSING VIOLATION	Lam	CASE UPDATE	AAB Reviewed. Ok to schedule case for 5/21/25 AAB. -GL	Gilbert Lam 14-MAR-25	CES
04/18/25	OTHER BLDG/ HOUSING VIOLATION	McConn	ORDER OF ABATEMENT POSTED	case update / this is to update case file that OOA was posted on 12/13/24 but the column Abatement type was put in as case update and not as Order of abatement posted - DMC	Declan McConn 16-APR-25	CES
05/21/25	OTHER BLDG/ HOUSING VIOLATION	McConn	CASE UPDATE	AAB case not scheduled for 5/21. AAB hearing date to be determined - CR	Charles Robinson 21-MAY-25	CES
05/29/25	OTHER BLDG/ HOUSING VIOLATION	McConn	CASE UPDATE	AAB hearing date scheduled for July 16, 2025. Called appellant / owner to inform her of July hearing. Emailed appellant / owner the AAB Notice of Hearing - CR	Charles Robinson 29-MAY-25	CES
05/29/25	OTHER BLDG/ HOUSING VIOLATION	McConn	CASE UPDATE	CM AAB NOH to owner on file-hb	Heather Brooks 29-MAY-25	CES



Welcome to our Permit / Complaint Tracking System!

E3

Electrical Permit Details Report

Report Date: 6/12/2025 11:43:10 AM

Application Number: EW202106296680

Address(es): 6210 /012 :338 TEDDY AV

Description: SURVEY PERMIT FOR ELECTRICAL. SITE DISCUSSION ONLY WITH AN INSPECTOR.
PLANNING ON REWIRING A PORTION OF THE HOME AND DOING A 200A SERVICE
UPGRADE

Stage:

Action Date	Stage	Comments
7/6/2021	COMPLETE	
6/29/2021	ISSUED	
6/29/2021	FILED	

Contractor Details:

License Number: 1040575
Name: ADOLFO ANDRADE-MEDAL
Company Name: ANDRADE LINK ELECTRIC CORP
Address: 679 PORTOLA DRIVE #202 SAN FRANCISCO, CA 94127-0000
Phone:

Appointment Details:

Appointment Date	Appointment AM/PM	Appointment Code	Appointment Type	Description	Time Slots
------------------	-------------------	------------------	------------------	-------------	------------

Inspection Details:

Inspector	Activity Date	Activity Code	Activity Code Descr.	Description
Robert Van Koll	7/6/2021	306	SURVEY COMPLETE	Not Available

For information, or to schedule an inspection, call: 628-652-3400.



Welcome to our Permit / Complaint Tracking System!

Permit Details Report

Report Date: 6/20/2025 10:14:34 AM

Application Number: 201806111530

Form Number: 8

Address(es): 6210 /012 /0 338 TEDDY AV

Description: TO COMPLY W/ NOV# 201763912, REPAIR STAIRCASE LESS THAN 50% INSTALL HANDRAIL ITEMS #4 & 5 TO CODE, REPAIR IN-KIND.

Cost: \$1,000.00

Occupancy Code: R-3

Building Use: 27 - 1 FAMILY DWELLING

Disposition / Stage:

Action Date	Stage	Comments
6/11/2018	TRIAGE	
6/11/2018	FILING	
6/11/2018	FILED	
6/11/2018	APPROVED	
6/11/2018	ISSUED	
9/11/2018	COMPLETE	4142094 Final Inspection/Approved

Contact Details:

Contractor Details:

License Number: OWN

Name: OWNER OWNER

Company Name: OWNER

Address: OWNER * OWNER CA 00000-0000

Phone:

Addenda Details:

Description:

Station	Rev#	Arrive	Start	In Hold	Out Hold	Finish	Checked By	Review Result	Hold Description
HIS		6/11/18	6/11/18			6/11/18	KARCS ANDREW		
CES		6/11/18	6/11/18			6/11/18			approved by JAMES LI
BLDG		6/11/18	6/11/18			6/11/18	WONG IRENE		
CPB		6/11/18	6/11/18			6/11/18	GREEN EMILIE		

This permit has been issued. For information pertaining to this permit, please call 628-652-3450.

Appointments:

Appointment Date	Appointment AM/PM	Appointment Code	Appointment Type	Description	Time Slots
------------------	-------------------	------------------	------------------	-------------	------------

Inspections:

Activity Date	Inspector	Inspection Description	Inspection Status
9/11/2018	Phillip Saunders	FINAL INSPECT/APPRVD	FINAL INSPECT/APPRVD
8/21/2018	Phillip Saunders	FINAL INSPECT/APPRVD	REINSPECT REQUIRED
8/28/2018	Phillip Saunders	FINAL INSPECT/APPRVD	ROUGH FRAME

Special Inspections:

Addenda No.	Completed Date	Inspected By	Inspection Code	Description	Remarks
-------------	----------------	--------------	-----------------	-------------	---------

For information, or to schedule an inspection, call 628-652-3400 between 8:30 am and 3:00 pm.

[Station Code Descriptions and Phone Numbers](#)

[Online Permit and Complaint Tracking home page.](#)

Technical Support for Online Services

If you need help or have a question about this service, please visit our [FAQ area](#)

City and County of
San Francisco

Home - Most Requested



Welcome to our Permit / Complaint Tracking System!

Permit Details Report

Report Date: 6/20/2025 10:09:16 AM

Application Number: 201805088575
Form Number: 8
Address(es): 6210 /012 /0 338 TEDDY AV
Description: to comply with nov # 201763912, dry rot repair front of building, less than 50% repair in kind
Cost: \$25,000.00
Occupancy Code: R-3
Building Use: 27 - 1 FAMILY DWELLING

Disposition / Stage:

Action Date	Stage	Comments
5/8/2018	TRIAGE	
5/8/2018	FILING	
5/8/2018	FILED	
5/8/2018	APPROVED	
5/8/2018	ISSUED	
6/4/2018	COMPLETE	3938894 Final Inspection/Approved

Contact Details:

Contractor Details:

License Number: OWN
Name: OWNER OWNER
Company Name: OWNER
Address: OWNER * OWNER CA 00000-0000
Phone:

Addenda Details:

Description:

Station	Rev#	Arrive	Start	In Hold	Out Hold	Finish	Checked By	Review Result	Hold Description
BLDG		5/8/18	5/8/18			5/8/18	WONG IRENE		
HIS		5/8/18	5/8/18			5/8/18	KARCS ANDREW		
CES		5/8/18	5/8/18			5/8/18	GUNNELL MICHAEL		
CPB		5/8/18	5/8/18			5/8/18	KARCS EVELYN		

This permit has been issued. For information pertaining to this permit, please call 628-652-3450.

Appointments:

Appointment Date	Appointment AM/PM	Appointment Code	Appointment Type	Description	Time Slots
------------------	-------------------	------------------	------------------	-------------	------------

Inspections:

Activity Date	Inspector	Inspection Description	Inspection Status
6/4/2018	Philip Saunders	FINAL INSPECT/APPRVD	FINAL INSPECT/APPRVD
5/25/2018	Philip Saunders	ROUGH FRAME, PARTIAL	ROUGH FRAME

Special Inspections:

Addenda No.	Completed Date	Inspected By	Inspection Code	Description	Remarks
-------------	----------------	--------------	-----------------	-------------	---------

For information, or to schedule an inspection, call 628-652-3400 between 8:30 am and 3:00 pm.

[Station Code Descriptions and Phone Numbers](#)

[Online Permit and Complaint Tracking home page.](#)

Technical Support for Online Services

If you need help or have a question about this service, please visit our [FAQ area](#).



Welcome to our Permit / Complaint Tracking System!

Permit Details Report

Report Date: 6/20/2025 10:12:47 AM

Application Number: 201805290319

Form Number: 8

Address(es): 6210 / 012 / 0 338 TEDDY AV

Description: Replace two front windows & two rear windows (aluminum) w/2 new wood sliding windows in the front & 2 vinyl windows @ rear; replace three skylights; replace existing sectional wood garage door w/new metal sectional garage door. REPAIR IN-KIND, TO COMPLY WITH HIS NOV 201763912 DATED 3/7/2017

Cost: \$8,000.00

Occupancy Code: R-3

Building Use: 27 - 1 FAMILY DWELLING

Disposition / Stage:

Action Date	Stage	Comments
5/29/2018	TRIAGE	
5/29/2018	FILING	
5/29/2018	FILED	
5/29/2018	APPROVED	
5/29/2018	ISSUED	
8/21/2018	COMPLETE	4107375 Final Inspection/Approved

Contact Details:

Contractor Details:

License Number: OWN
Name: OWNER OWNER
Company Name: OWNER
Address: OWNER * OWNER CA 00000-0000
Phone:

Addenda Details:

Description:

Station	Rev#	Arrive	Start	In Hold	Out Hold	Finish	Checked By	Review Result	Hold Description
BLDG		5/29/18	5/29/18			5/29/18	WONG IRENE		
CP-ZOC		5/29/18	5/29/18			5/29/18			APPROVED BY LINDA AJELLO HOAGLAND
CES		5/29/18	5/29/18			5/29/18	GUNNELL MICHAEL		
HIS		5/29/18	5/29/18			5/29/18	SANBONMATSU JAMES		
CPB		5/29/18	5/29/18			5/29/18	PASION MAY		

This permit has been issued. For information pertaining to this permit, please call 628-652-3450.

Appointments:

Appointment Date	Appointment AM/PM	Appointment Code	Appointment Type	Description	Time Slots
------------------	-------------------	------------------	------------------	-------------	------------

Inspections:

Activity Date	Inspector	Inspection Description	Inspection Status
8/21/2018	Philip Saunders	FINAL INSPECT/APPRVD	FINAL INSPECT/APPRVD

Special Inspections:

Addenda No.	Completed Date	Inspected By	Inspection Code	Description	Remarks
-------------	----------------	--------------	-----------------	-------------	---------

For information, or to schedule an inspection, call 628-652-3400 between 8:30 am and 3:00 pm.

Station Code Descriptions and Phone Numbers

Online Permit and Complaint Tracking home page.

Technical Support for Online Services

If you need help or have a question about this service, please visit our [FAQ](#) area.



Welcome to our Permit / Complaint Tracking System!

Permit Details Report

Report Date: 6/20/2025 10:11:14 AM

Application Number: 201806040955
Form Number: 8
Address(es): 6210 /012 /0 338 TEDDY AV
Description: Revision to #2018.05.29.0319 to replace only (1) front window aluminum-clad wood window at front facade (left window). Replace garage door only, repair in kind, BUILDING IS 2-STORIES PER IRENE WONG, 6/4/2018, TO COMPLY WITH HIS NOV 201763912 DATED 3/7/2017.
Cost: \$1.00
Occupancy Code: R-3
Building Use: 27 - 1 FAMILY DWELLING

Disposition / Stage:

Action Date	Stage	Comments
6/4/2018	TRIAGE	
6/4/2018	FILING	
6/4/2018	FILED	
6/5/2018	APPROVED	
6/5/2018	ISSUED	
9/21/2018	COMPLETE	4107294 Final Inspection/Approved

Contact Details:

Contractor Details:

License Number: OWN
Name: OWNER OWNER
Company Name: OWNER
Address: OWNER * OWNER CA 00000-0000
Phone:

Addenda Details:

Description:

Station	Rev#	Arrive	Start	In Hold	Out Hold	Finish	Checked By	Review Result	Hold Description
BLDG		6/4/18	6/4/18			6/4/18	WONG IRENE		
CP-ZOC		6/4/18	6/4/18			6/4/18	ADINA SEEMA		
CES		6/5/18	6/5/18			6/5/18	GREENE EDWARD		
HIS		6/5/18	6/5/18			6/5/18	LOPEZ JOSE		
CPB		6/5/18	6/5/18			6/5/18	PASION MAY		

This permit has been Issued. For information pertaining to this permit, please call 628-652-3450.

Appointments:

Appointment Date	Appointment AM/PM	Appointment Code	Appointment Type	Description	Time Slots
------------------	-------------------	------------------	------------------	-------------	------------

Inspections:

Activity Date	Inspector	Inspection Description	Inspection Status
8/21/2018	Phillip Saunders	FINAL INSPECT/APPRVD	FINAL INSPECT/APPRVD

Special Inspections:

Addenda No.	Completed Date	Inspected By	Inspection Code	Description	Remarks
-------------	----------------	--------------	-----------------	-------------	---------

For information, or to schedule an inspection, call 628-652-3400 between 8:30 am and 3:00 pm.

[Station Code Descriptions and Phone Numbers](#)

[Online Permit and Complaint Tracking home page.](#)

Technical Support for Online Services

If you need help or have a question about this service, please visit our [FAQ area](#)



Welcome to our Permit / Complaint Tracking System!

Permit Details Report

Report Date: 6/19/2025 2:13:25 PM

Application Number: 202108116263

Form Number: 8

Address(es): 6210 /012 /0 338 TEDDY AV

Description: To comply with NOV 202179766. Legalize ground fir addition (approx. 792 SF). new bedroom, new recreation room, new closet, new bar/lounge, new bathroom, and new laundry.

Cost: \$10,000.00

Occupancy Code: R-3

Building Use: 27 - 1 FAMILY DWELLING

Disposition / Stage:

Action Date	Stage	Comments
8/11/2021	TRIAGE	
8/11/2021	FILING	
8/11/2021	FILED	

Contact Details:

Contractor Details:

Addenda Details:

Description:

Station	Rev#	Arrive	Start	In Hold	Out Hold	Finish	Checked By	Phone	Review Result	Hold Description
BID- INSP		10/26/21	10/26/21			10/26/21	MCHUGH KEVIN	415-558-6096		
BID- INSP		8/11/21	8/11/21			8/11/21	BIRMINGHAM KEVIN	415-558-6096		
CES		8/11/21	8/11/21			8/11/21		628-652-3430		Ok to process per M. Chung
CES		10/26/21	10/26/21			10/26/21	HINCHION JOHN	628-652-3430		
INTAKE		8/11/21	8/11/21			8/11/21	LEE ERIC	415-999-9999		
INTAKE		10/26/21	10/26/21			10/26/21	VICTORIO CHRISTOPHER	415-999-9999		New Set of Plans 18 pages
CP-ZOC							DITO MATTHEW	628-652-7300		Requires pre-app for horizontal addition greater than 10 feet. Applicant instructed that existing drawings should be before addition was constructed, proposed should be as-built. Needs side and rear elevations.
BLDG								628-652-3780		
PAD- STR								628-652-3780		
MECH								628-652-3780		
SFPUC								628-652-6040		
CPB								628-652-3240		

Appointments:

Appointment Date	Appointment AM/PM	Appointment Code	Appointment Type	Description	Time Slots
------------------	-------------------	------------------	------------------	-------------	------------

Inspections:

Activity Date	Inspector	Inspection Description	Inspection Status
---------------	-----------	------------------------	-------------------

Special Inspections:

Addenda No.	Completed Date	Inspected By	Inspection Code	Description	Remarks
-------------	----------------	--------------	-----------------	-------------	---------

For information, or to schedule an inspection, call 628-652-3400 between 8:30 am and 3:00 pm.

[Station Code Descriptions and Phone Numbers](#)

[Online Permit and Complaint Tracking home page.](#)

Technical Support for Online Services

If you need help or have a question about this service, please visit our [FAQ area](#).





